


T 6 N., R 35 E., W.M.

2 PROVISIONS OF
SECTION

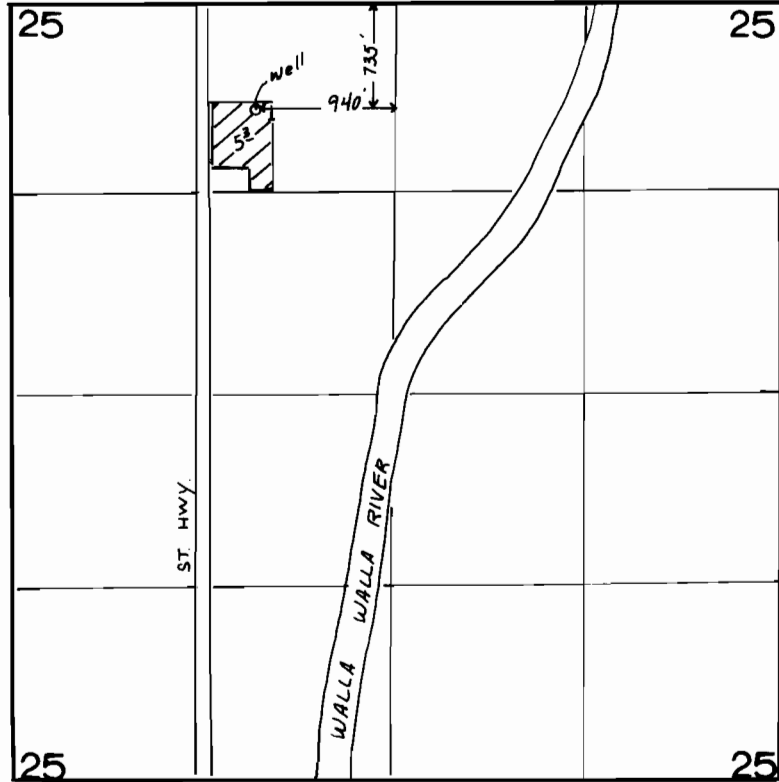

1" = 1320'

FINAL PROOF SURVEY
UNDER

Application No. G-11643. Permit No. G.10785.....
IN NAME OF

..... PAUL A. WILLIAMS

Surveyed 10-19... 2000., by ...J.MILLER.....