


T. 4 N., R. 28 E., W.M.

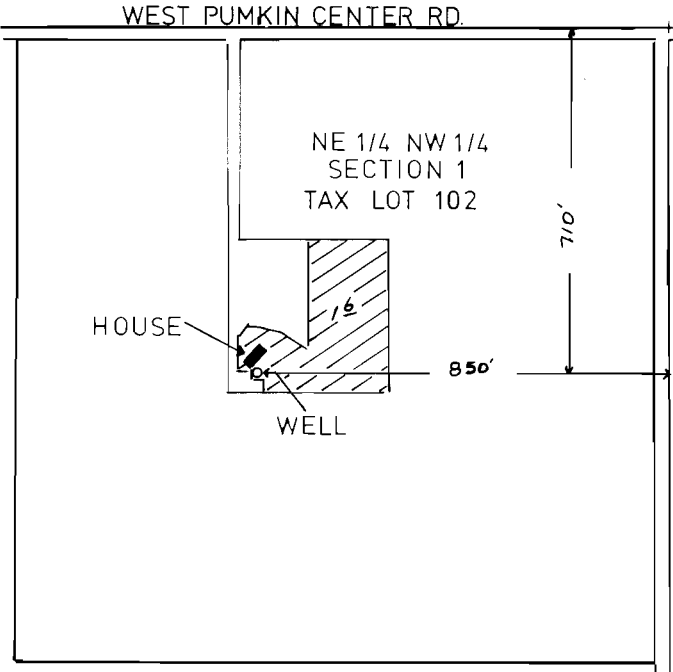

FINAL PROOF SURVEY
UNDER

Application No. G-11423 Permit No. G-10556
IN NAME OF

DAVID C. SCHULZ

Surveyed July 19, 1995, by J. Miller