


T. 32 S., R. 5 W., W. M.

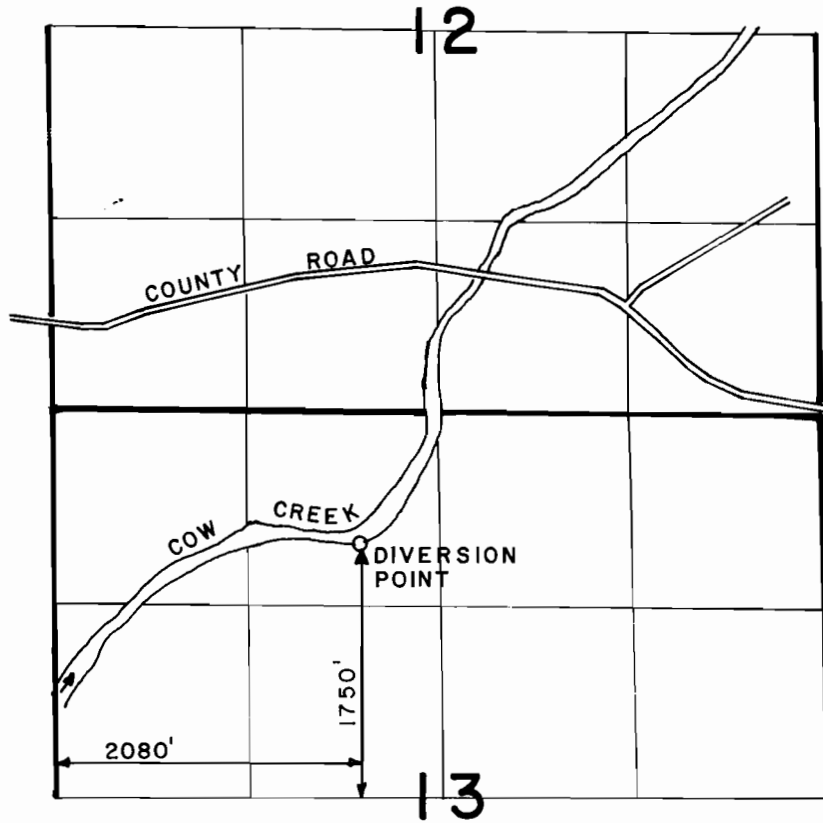

SCALE: 4" = 1 MILE

FINAL PROOF SURVEY
UNDER

TRANSFER NO. T-5547
IN NAME OF

JOHN W. ROGERS

Surveyed JULY 12, 1989, by J. M. SCHMORDE