


T.13S. R.33E. W.M.


T-5600

EXISTING PLACE
OF USE

4" = 1 mile

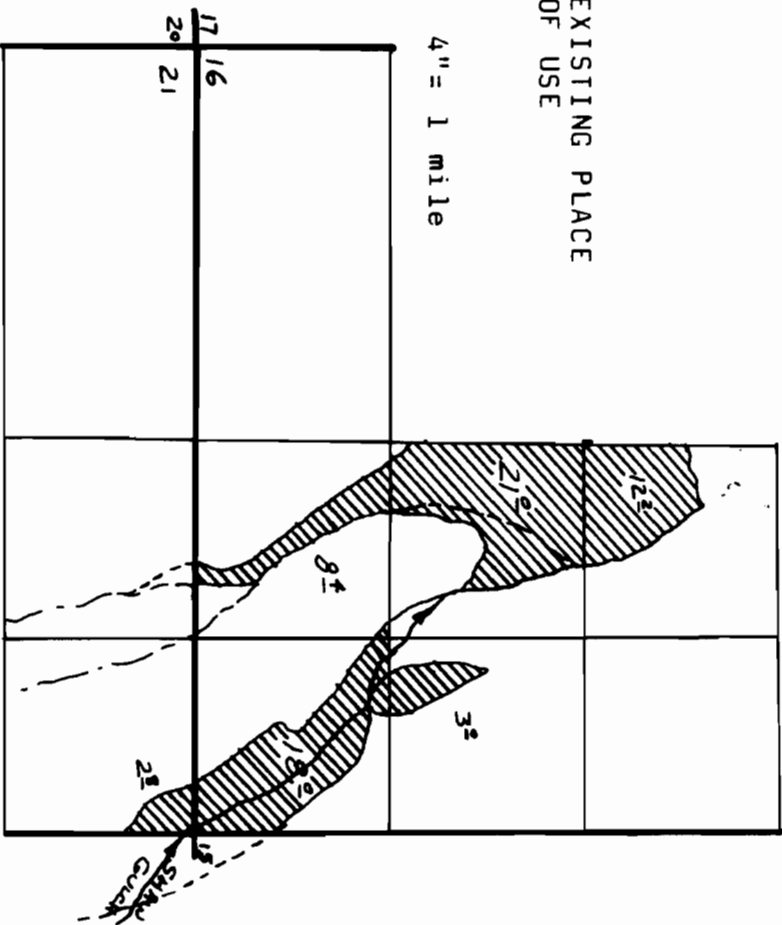


PROPOSED PLACE OF USE

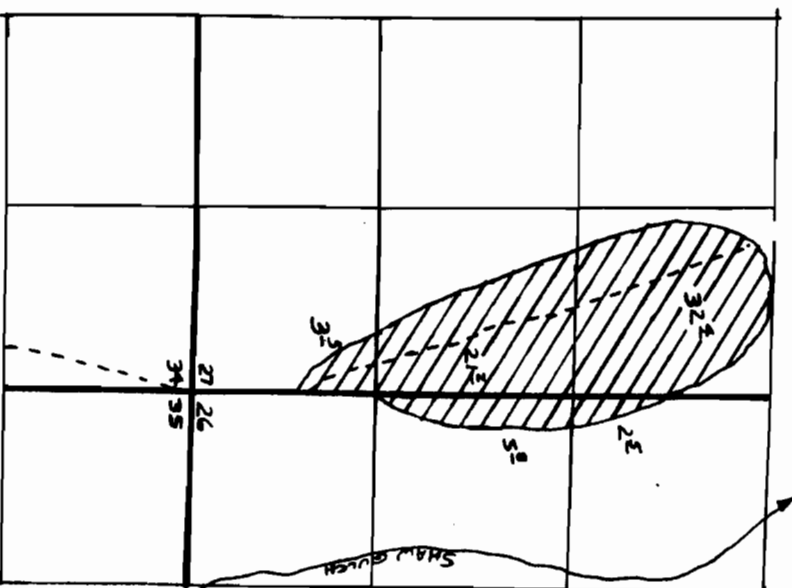

T.14S R.33E Section 10
Diversion Point
700'S & 40'W from E &
corner of Section 10

4" = 1 mile

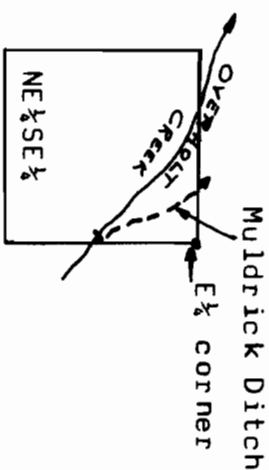

RECEIVED

FEB 28 1985
WATER RESOURCES DEPT.
SALEM, OREGON