


T. 13S., R. 31E., W.M.

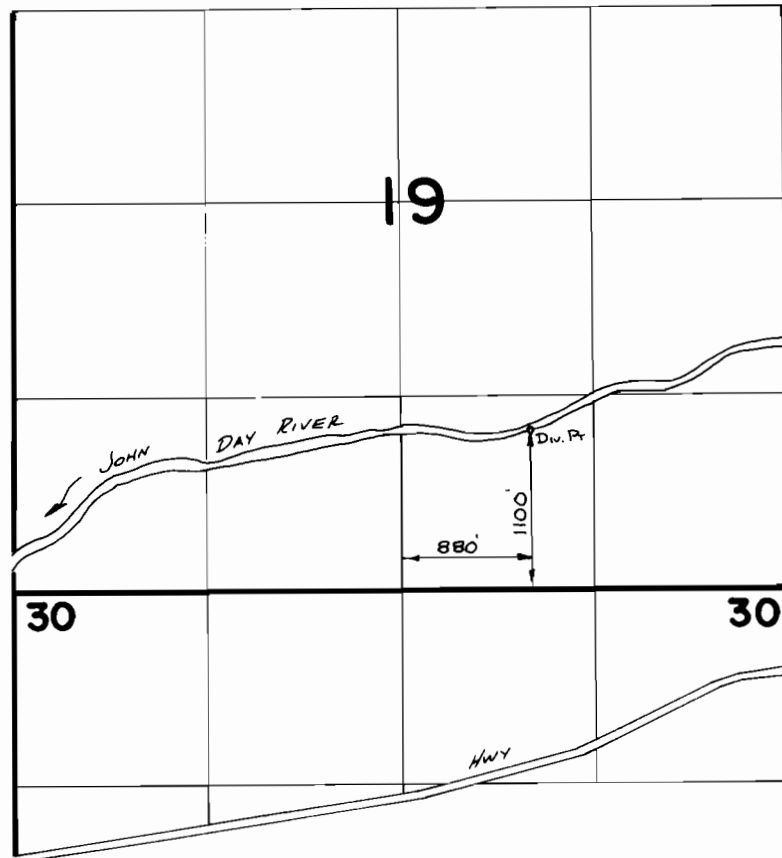

N  
SCALE 1" = 1320'

**FINAL PROOF SURVEY**  
UNDER

**TRANSFER 4846**  
IN NAME OF

.....**RAMONA MORRIS**.....

Surveyed 3-19..... 1986, by V.L. Church.....