


T. 13S., R. 31E., W.M.

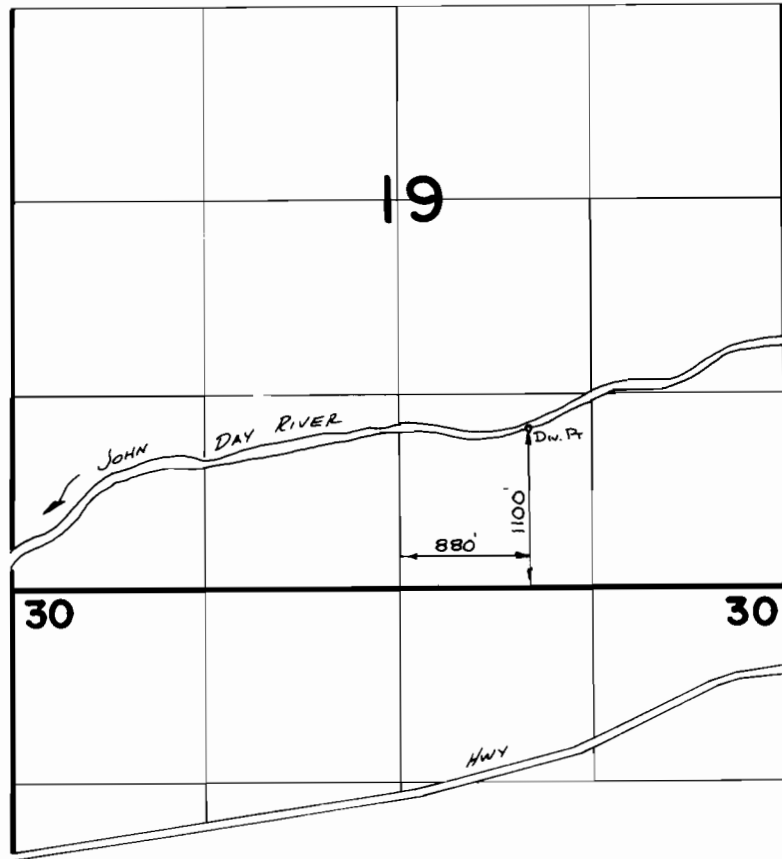

SCALE 1" = 1320'

FINAL PROOF SURVEY
UNDER

TRANSFER 4846
IN NAME OF

RAMONA MORRIS

Surveyed 3-19 1986, by V. L. Church