


T. 13S., R. 31E., W.M.

N
SCALE 1" = 1320'

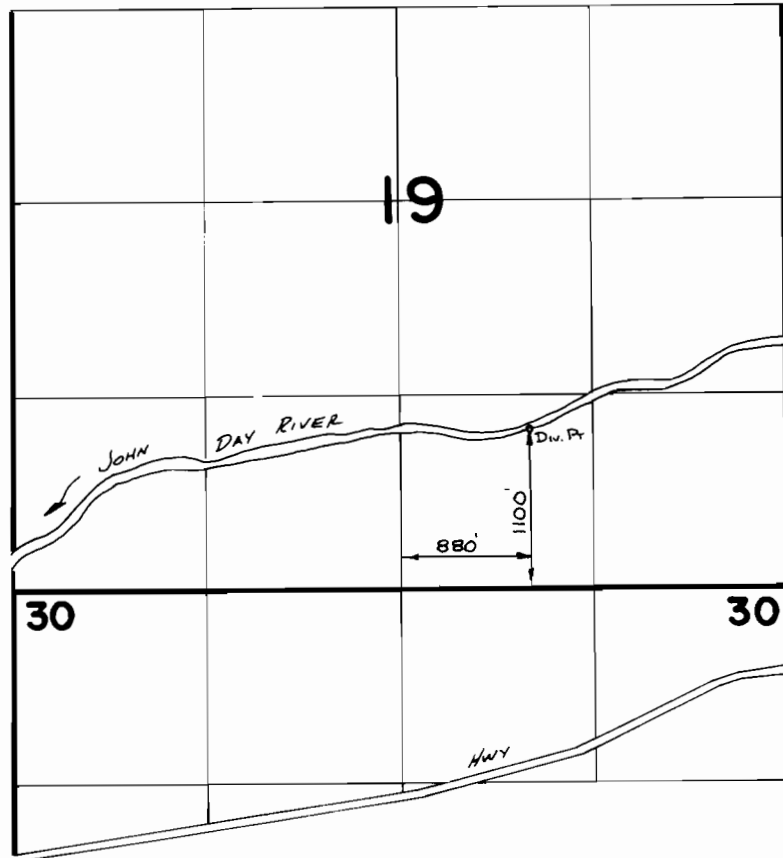

FINAL PROOF SURVEY
UNDER

TRANSFER 4846
IN NAME OF

.....**RAMONA MORRIS**.....

Surveyed 3-19..... 1986, by V.L. Church.....