T.22S. R.7W.W.M.

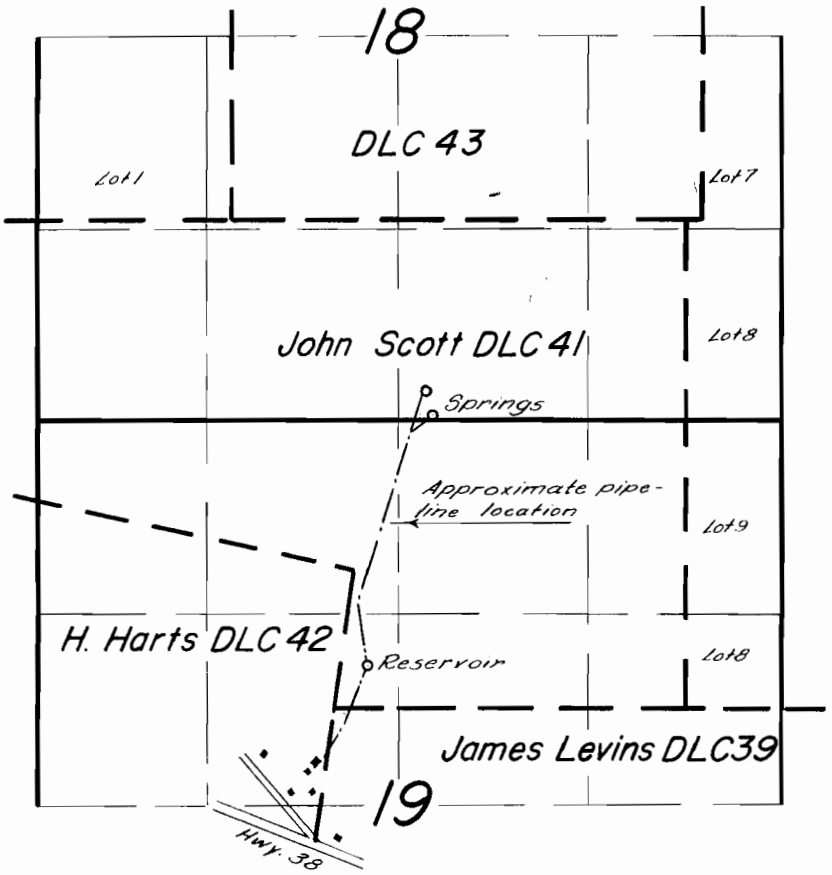

Note: Spring locations taken from application map.

FINAL PROOF SURVEY
UNDER

Application No. 34652 Permit No. 27466
IN NAME OF

Frank W. & Nellie M. Binder

Surveyed Aug. 30 1962, by C.O. Bartels