


T. 24S., R. 32 1/2 E., W.M.

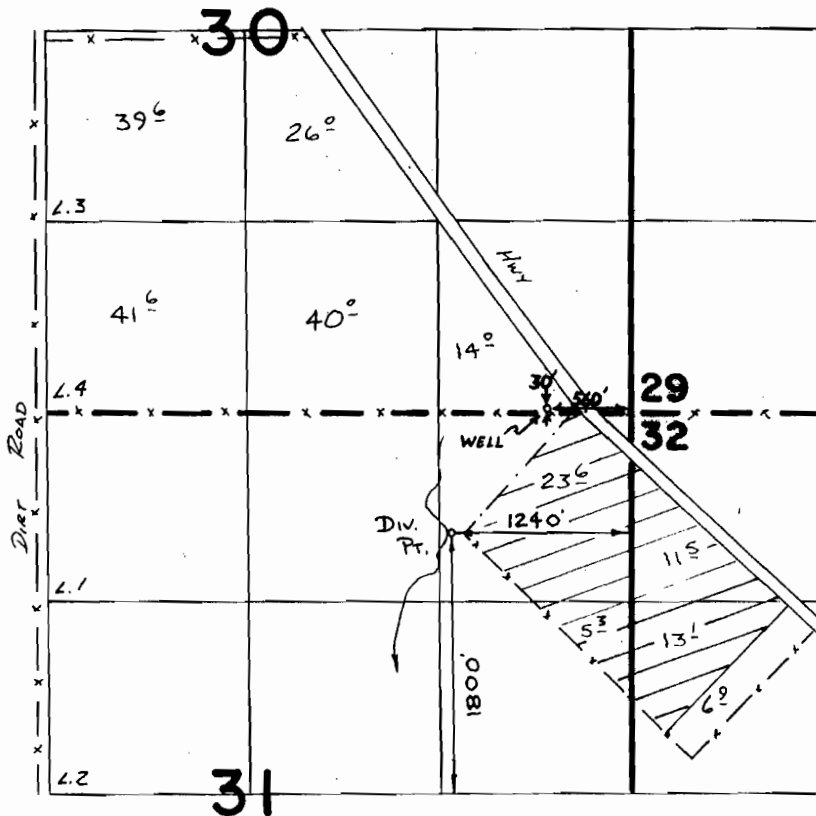

SCALE 1" = 1320'

**FINAL PROOF SURVEY**  
UNDER

G-11378      G10512  
Application No. 68368      Permit No. 49406  
IN NAME OF

JAMES W. MASON, JR.

Surveyed ... 5-9 ... 1988, by V.L. Church