


TOWNSHIP 3 SOUTH, RANGE 45 EAST, W. M.

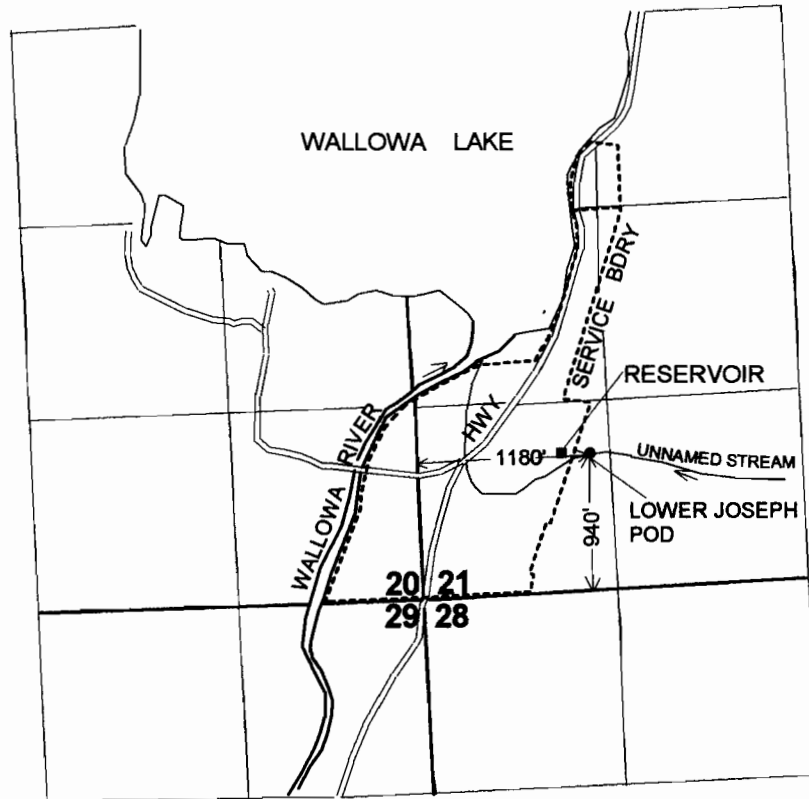

1" = 1320'

**FINAL PROOF SURVEY**  
UNDER  
**Application 69066 Permit 52402**  
IN THE NAME OF  
**CHIEF JOSEPH RESORT WATER DISTRICT**  
Surveyed: 6-19-2002 by: J. Miller

**RECEIVED**

FEB 03 2003

WATER RESOURCES DEPT.  
SALEM, OREGON