


T. 11 & 12 S. R. 20 E. W.M.

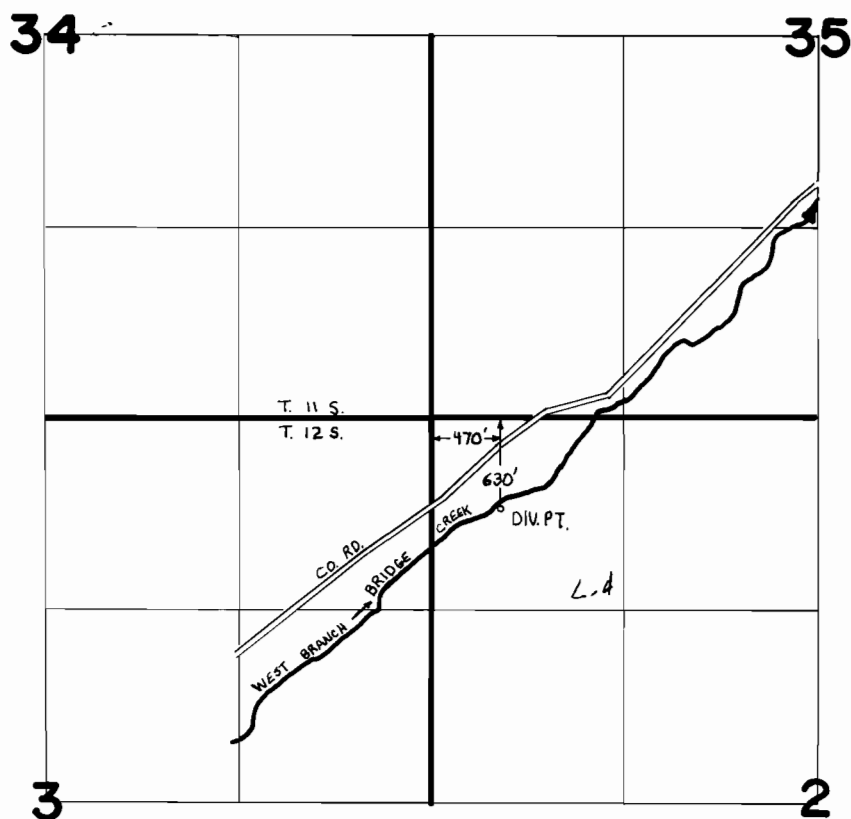

Scale 1"=1320'



FINAL PROOF SURVEY UNDER

TRANSFER 4839

IN NAME OF

MICHAEL PATRICK CARROLL

Surveyed April 23, 1986, by V. Church.....