

T-5738

T11S R20E

Section 35 SW $\frac{1}{4}$

RECEIVED

JAN 26 1993

WATER RESOURCES DEPT.
SALEM, OREGON

TRANSFER APPLICATION MAP
FOR MARVIN L. HALSTEAD

RECEIVED

DEC 12 1985

WATER RESOURCES DEPT.
SALEM, OREGON

N

NW $\frac{1}{4}$ SW $\frac{1}{4}$

NE $\frac{1}{4}$ SW $\frac{1}{4}$

SW $\frac{1}{4}$ SW $\frac{1}{4}$

SE $\frac{1}{4}$ SW $\frac{1}{4}$

P-48110

U.S. HWY. 26

PROPOSED
DIVERSION

E.W. TAYLOR DITCH #2


WEST BRANCH BRIDGE CREEK

S $\frac{1}{4}$
CORNER

1" = 400'

EXISTING

Diversion Point is 960'S & 170'E from the Center $\frac{1}{4}$ corner of Section 3 within the NW $\frac{1}{4}$ SE $\frac{1}{4}$ of Section 3 T12S R20E WM.

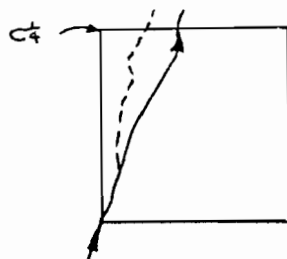


Diversion Inset scale - 4" = 1 mile

PROPOSED

820'N & 620'W from S $\frac{1}{4}$ corner of Section 35 within SE $\frac{1}{4}$ SW $\frac{1}{4}$ of Sec. 35 T11S R20E WM.

T. 11 S., R. 20 E., W.M.

USE FOR POD LOCATION
ONLY

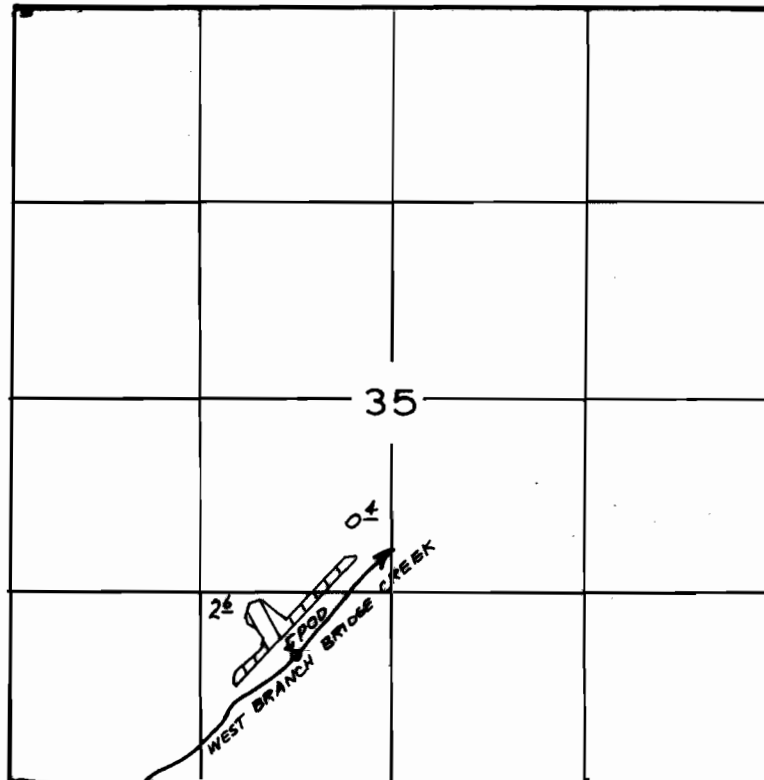

POD - 820' N. & 620' W. FROM THE S 1/4 CORNER SEC. 35.

FINAL PROOF SURVEY

UNDER

Application No. 66899 Permit No. 48110
IN NAME OF

MARVIN AND PHYLLIS HALSTEAD

Surveyed 9-10, 1992, by J. MILLER