


T. 12S., R. 20E., W.M.

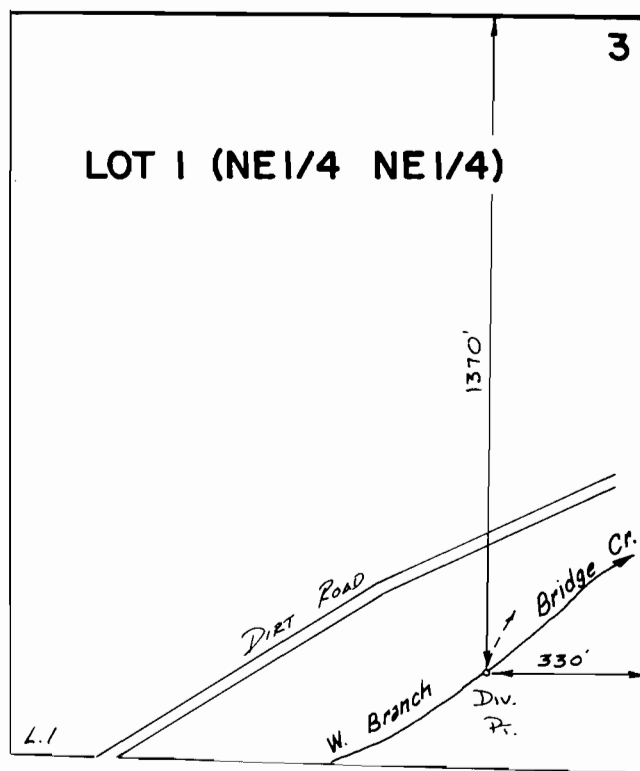

FINAL PROOF SURVEY
UNDER

TRANSFER 5788
IN NAME OF

ROCKY J. COLEMAN

Surveyed 5-11 1987, by V.L. Church