

STAFF INTERPRETER COPY

RECEIVED
JAN 26 2005
WATER RESOURCES DEPT
SALEM, OREGON

x 4207
RECEIVED

DEC 09 2004

WATER RESOURCES DEPT
SALEM, OREGON

app # R 86086
Permit # R 14155




**WORK
COPY**

HYDRO SCALE
1" = 1000 FEET

RESERVOIR LOCATED FROM
SW CORNER SECTION 2
2950 ft NORTH Spring
1750 ft EAST

T 5 S R 27 E

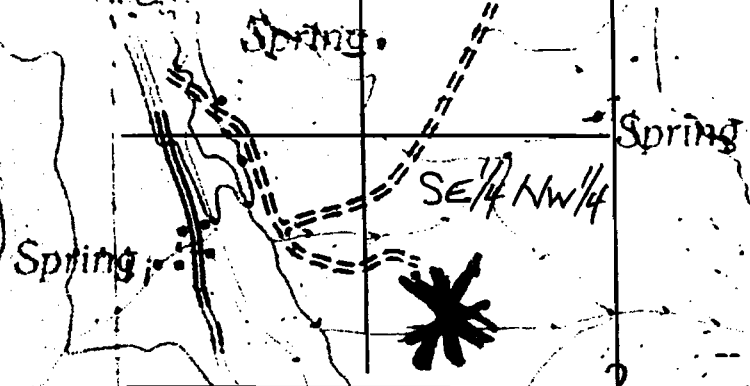

RECEIVED
AUG 14 2006
WATER RESOURCES DEPT
SALEM, OREGON

**SECTION
2**

4829