


T. 13S., R. 28 & 29E., W.M.

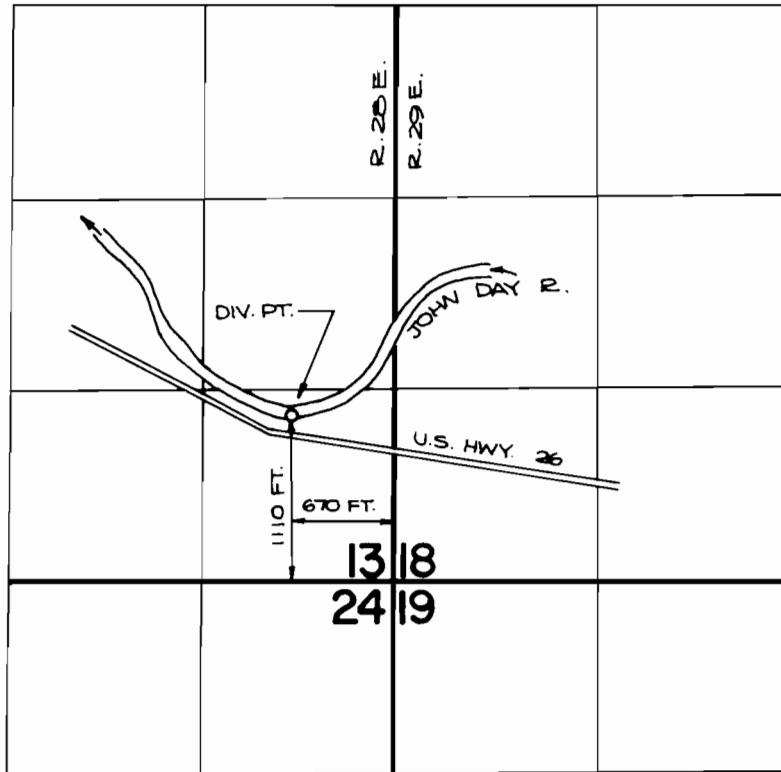

SCALE: 4" = 1 MILE

FINAL PROOF SURVEY
UNDER

TRANSFER NO. 4809

IN NAME OF

.....**MARY HILDA TIRICO**.....

Surveyed AUG. 6, 1984., by *P. Paster*.....