


T.2S., R.44E., W.M.

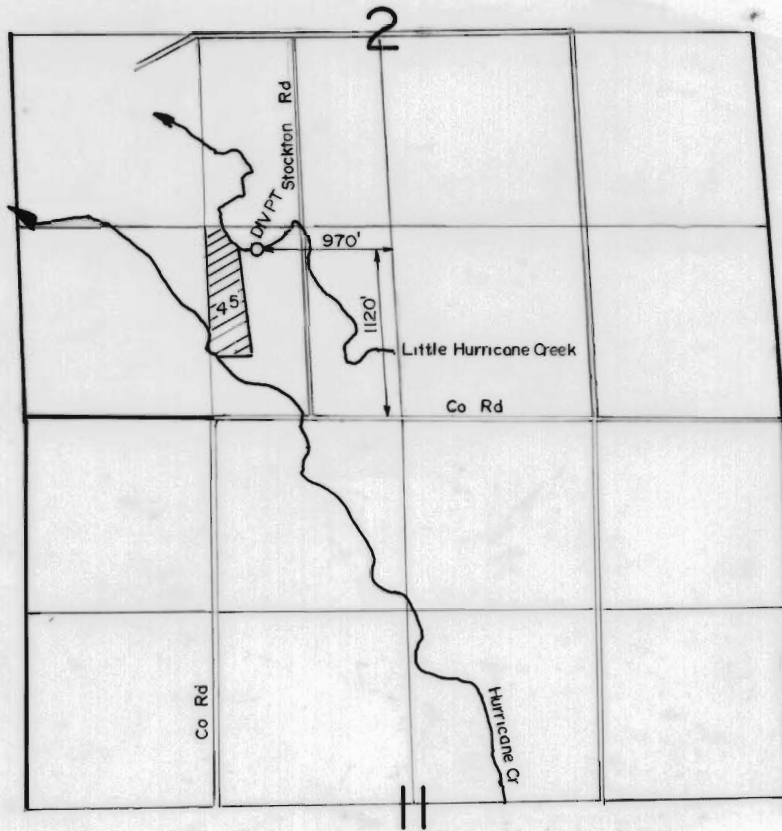

SCALE: 1"=1320'

FINAL PROOF SURVEY
UNDER

TRANSFER NO. 5684

Application No. Permit No.

IN NAME OF

..... **JIM HALL**

Surveyed AUG. 9..... 1988., by V.L. CHURCH.....