


T.13S.,R.28E.,W.M.

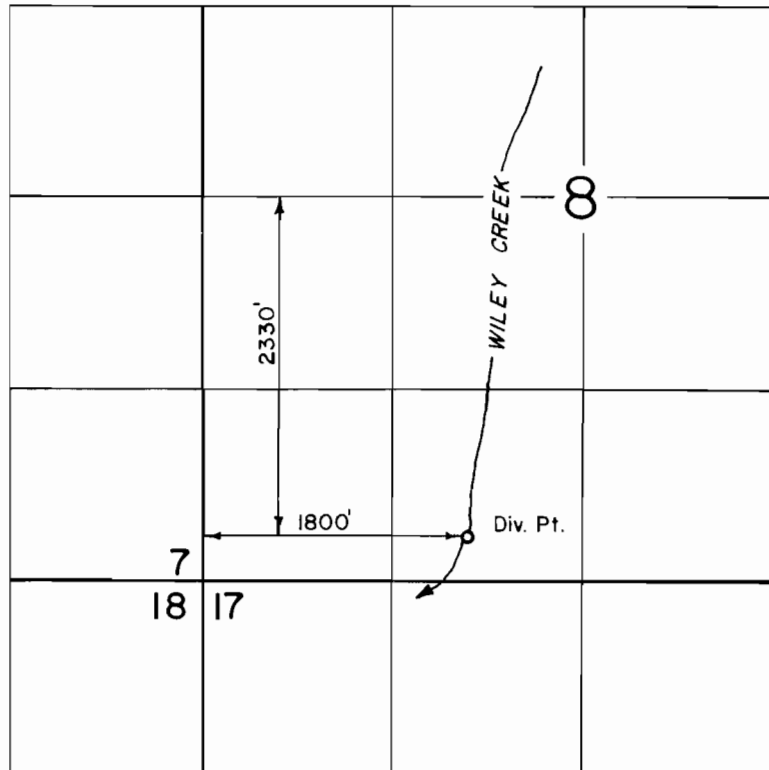

FINAL PROOF SURVEY
UNDER

TRANSFER NO. 4199

IN NAME OF
NANCY GRIMM

Surveyed SEPT. 2, 1981, by *AB Brown*