


# T. 5 N., R. 36 E., W.M.

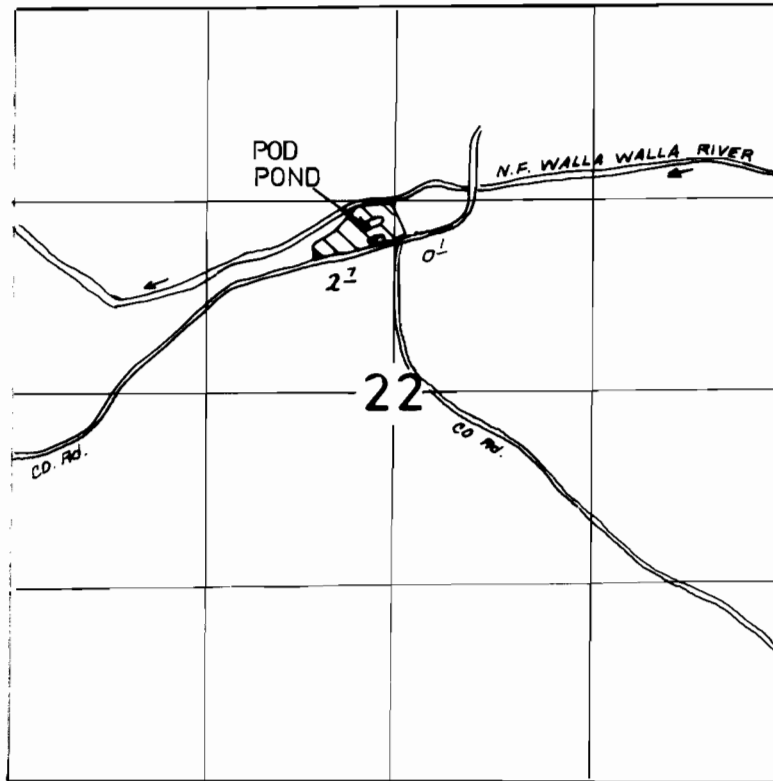

POD-1170' N. AND 230' W. FROM THE CEN. COR. SEC. 22.

## FINAL PROOF SURVEY

UNDER

Application No. 68234 Permit No. 49268  
IN NAME OF

JAMES A. INGALS

Surveyed 7-14, 1993, by J. MILLER