


T. 5 N., R. 32 E., W.M.

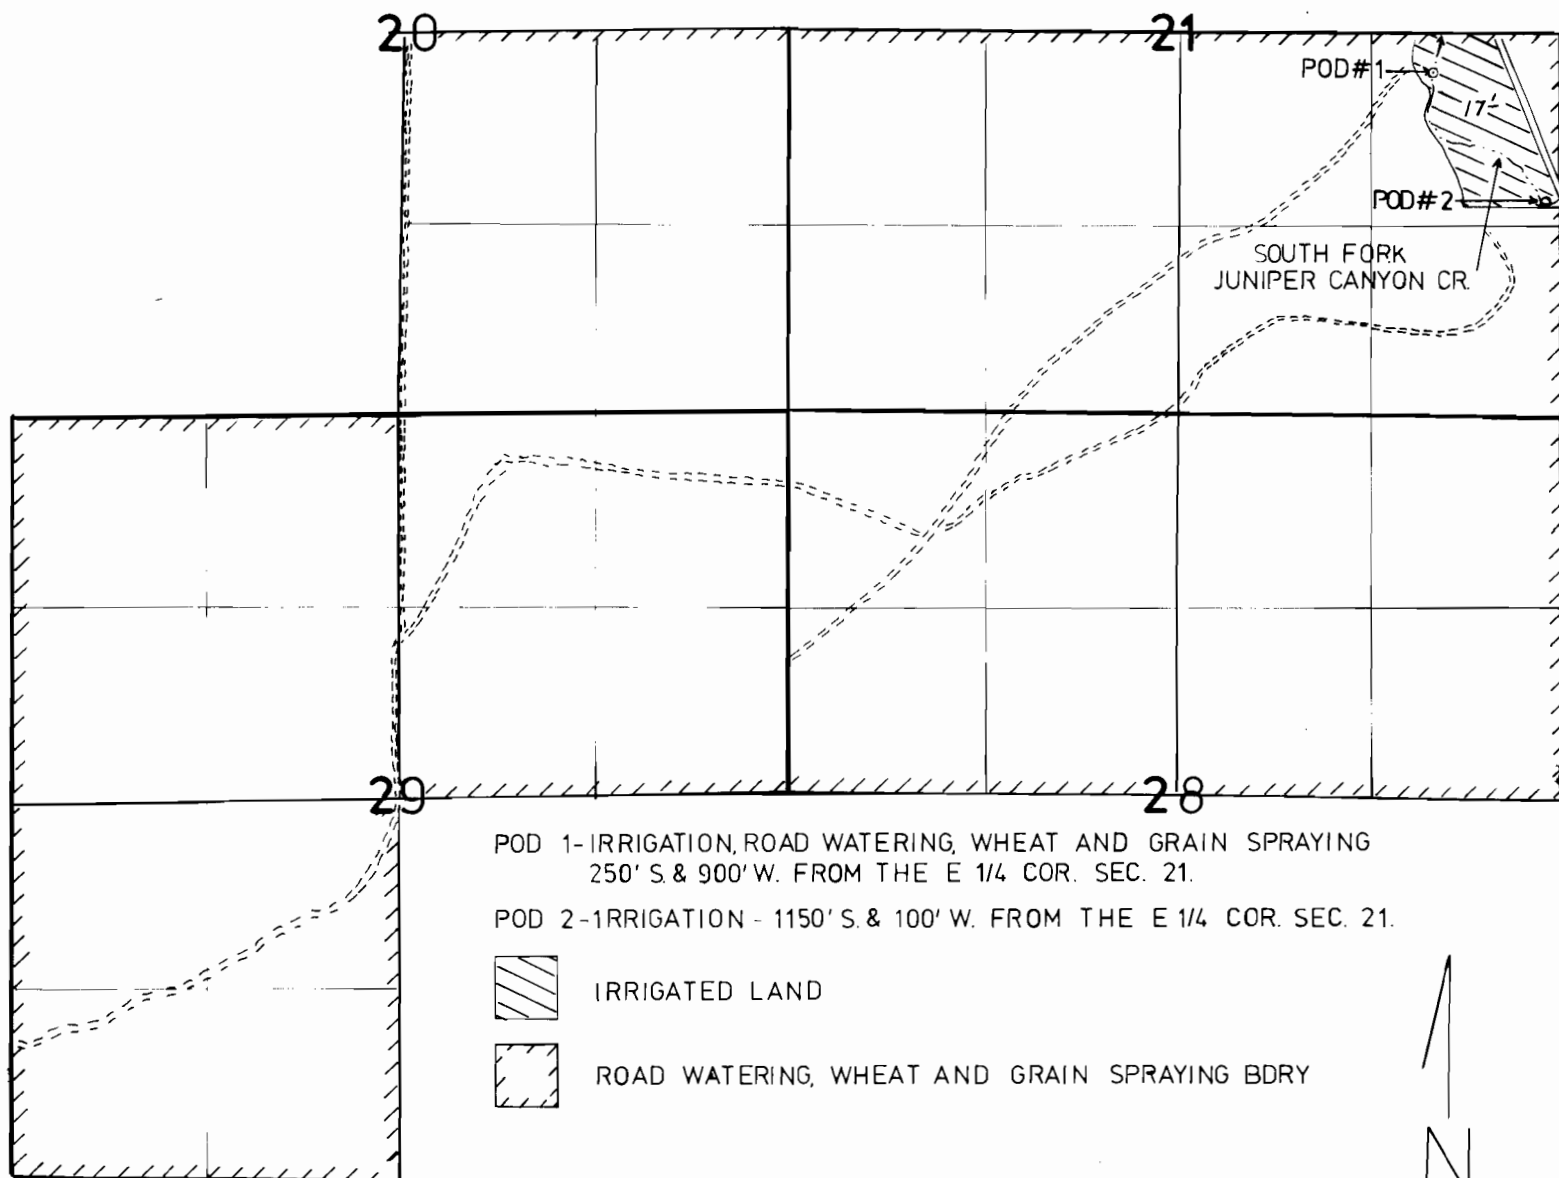

POD 1-IRRIGATION, ROAD WATERING, WHEAT AND GRAIN SPRAYING
250' S. & 900' W. FROM THE E 1/4 COR. SEC. 21.

POD 2-IRRIGATION - 1150' S. & 100' W. FROM THE E 1/4 COR. SEC. 21.



IRRIGATED LAND



ROAD WATERING, WHEAT AND GRAIN SPRAYING BDY

FINAL PROOF SURVEY UNDER

Application No. 65150 Permit No. 47825
IN NAME OF

BRYAN L. AND KATHY A. JONES

Surveyed August 12, 1994, by J. Miller

1" = 1320'