



TOWNSHIP 1 SOUTH, RANGE 48 EAST, W.M.

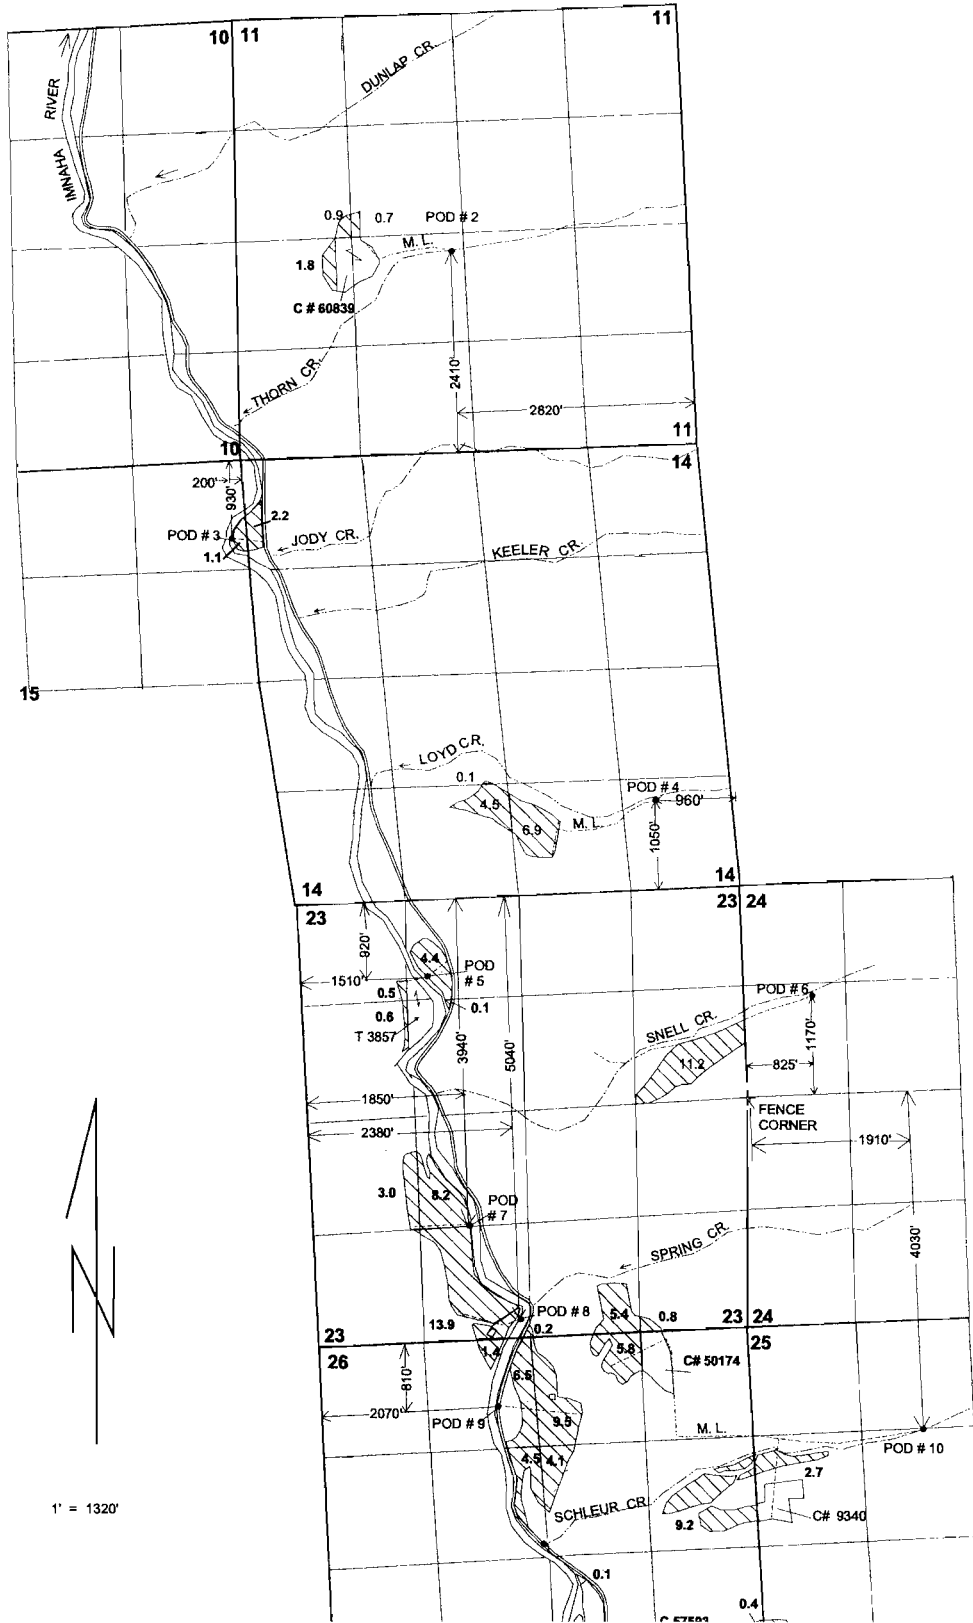



1" = 1320'

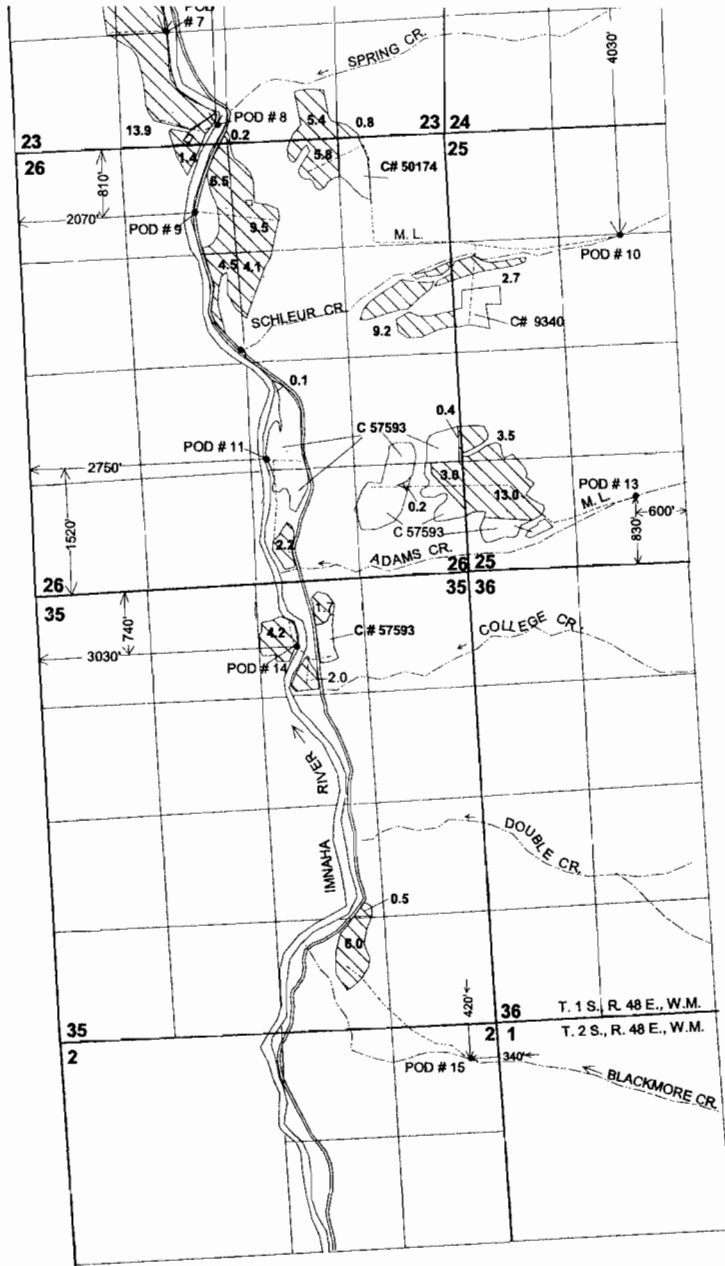

FINAL PROOF SURVEY
UNDER
Application No. 49222 Permit No. 44683
IN THE NAME OF
IMNAHA SPRINKLER ASSOCIATION
AND
STOCKMAR CORPORATION
Surveyed: June 3, 4 & 5, 2002, by: J. Miller