



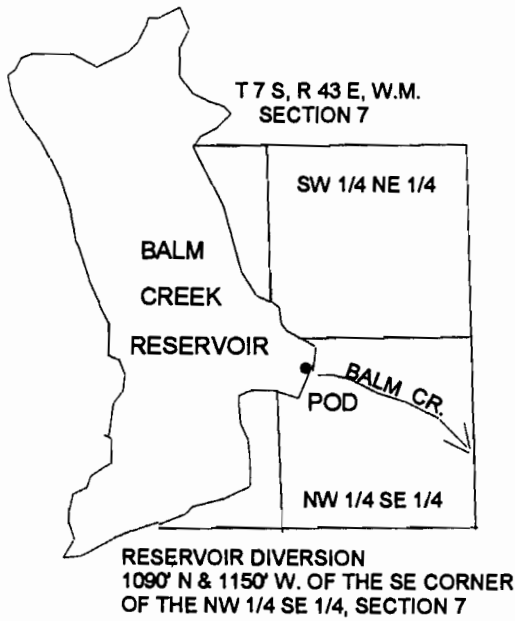

FINAL PROOF SURVEY
UNDER
Application No. 63711 Permit No. 48143
IN THE NAME OF
RALPH H. JACOBS
Surveyed: August 27, 2002 by: J. Miller

RECEIVED
MAR 03 2003
WATER RESOURCES DEPT
SALEM, OREGON

