


T. 7 & 8 S., R. 38 E., W.M.

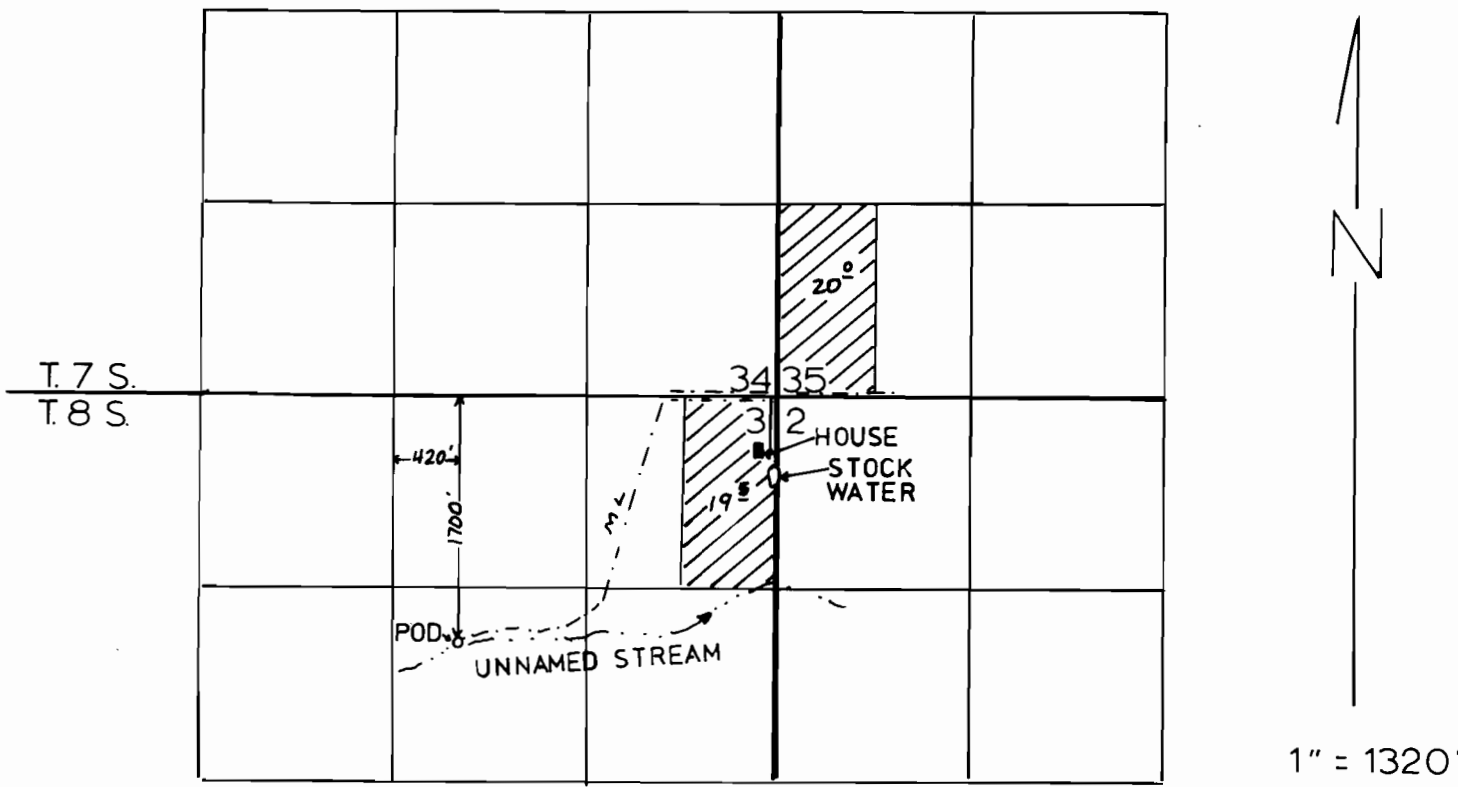

FINAL PROOF SURVEY

UNDER

Application No. 58096 Permit No. 44276
IN NAME OF

JAMES E. KERNS

Surveyed AUGUST 4, 1994, by J. MILLER