


T. 1 S., R. 48 E., W.M.

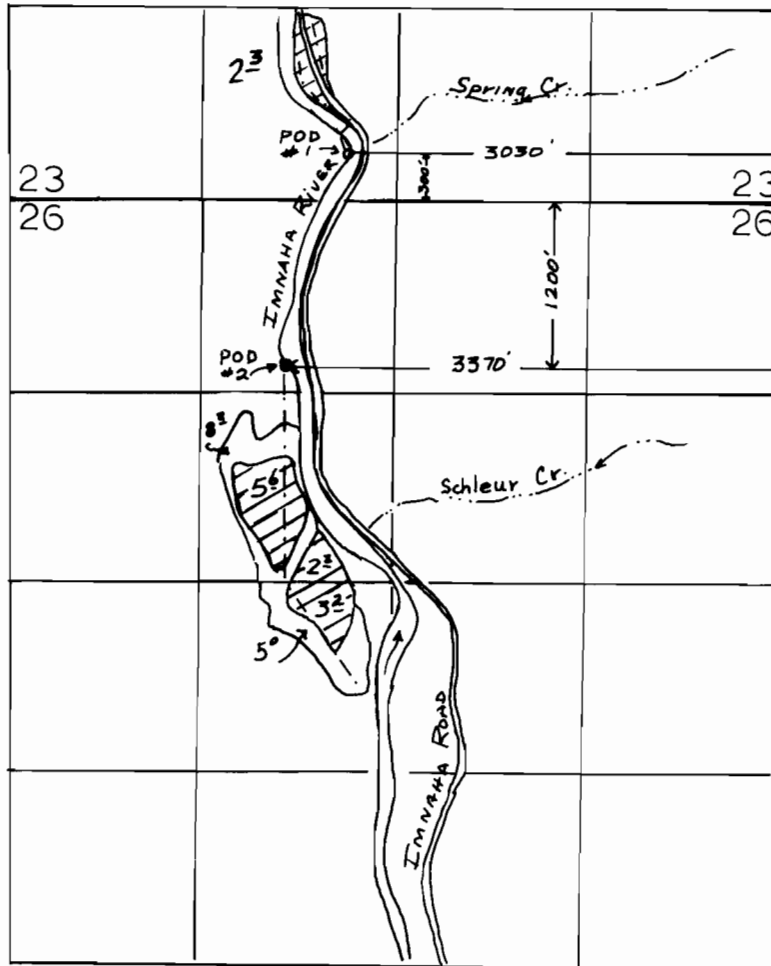

FINAL PROOF SURVEY

UNDER

Application No. 68146 Permit No. 48759
IN NAME OF

LARRY GUTHERIE

Surveyed 10-8, 1990, by K. KEMP