


T. 1 S., R. 38 E., W.M.

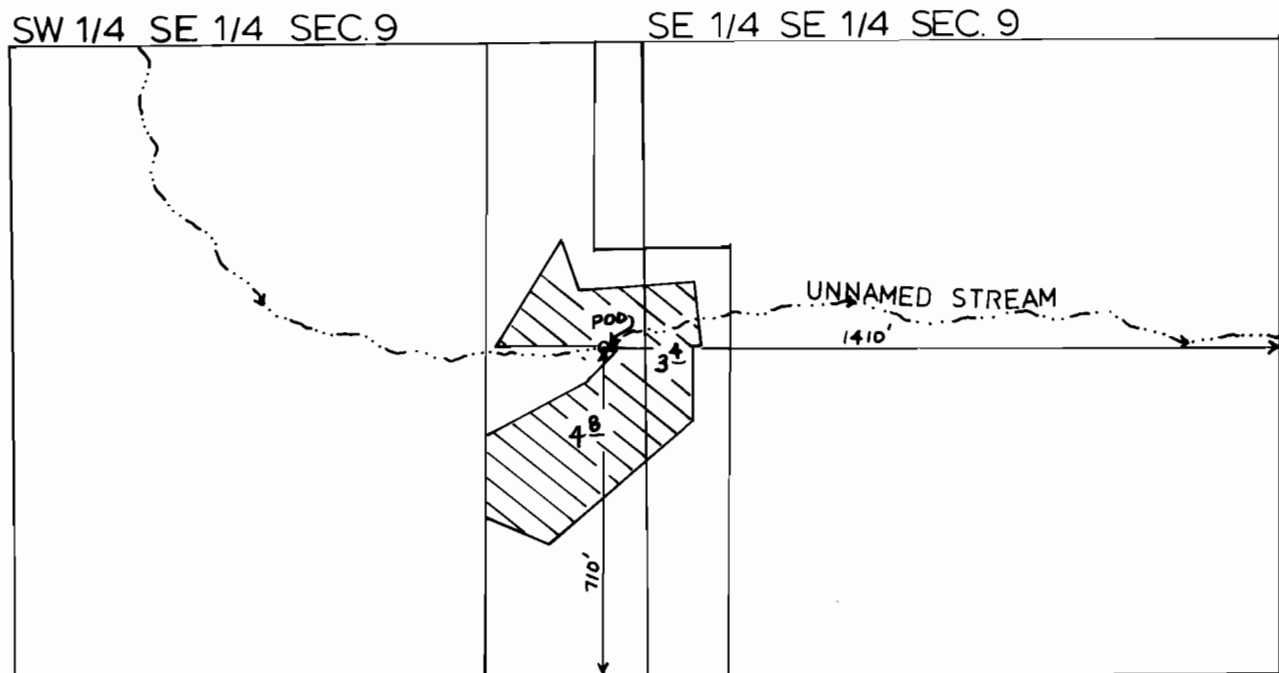

1" = 400'

FINAL PROOF SURVEY

UNDER

Application No. 66094 Permit No. 48431
IN NAME OF

GEORGE AND VELMA MONROE

Surveyed 3-20, 1991, by K. KEMP

Drafted 12-15-93 J.M. P.T.S.