


TOWNSHIP 1 SOUTH, RANGE 47 EAST, W.M.

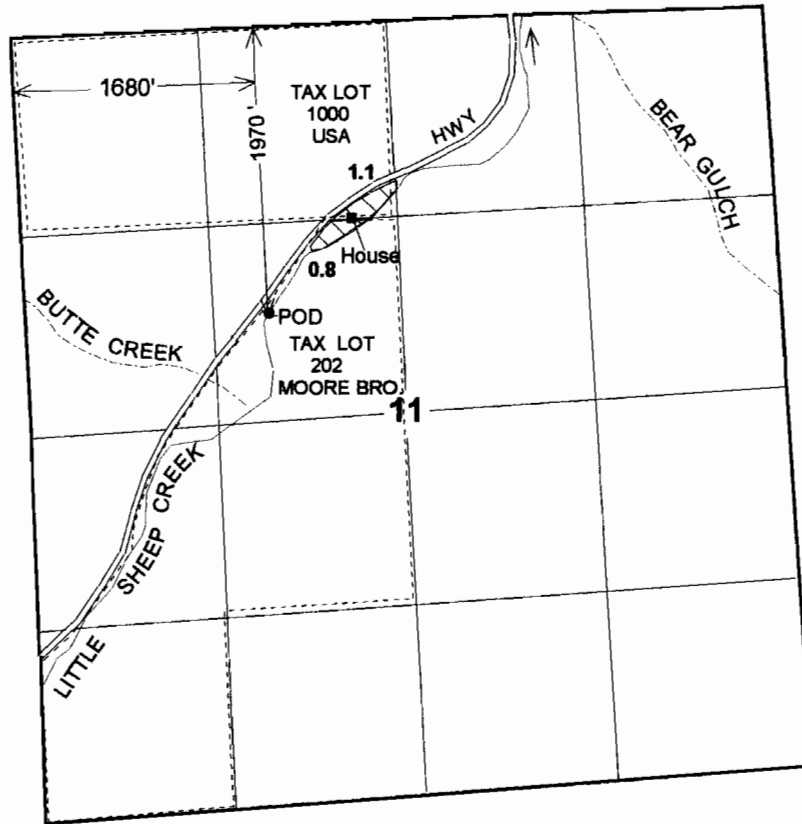

FINAL PROOF SURVEY
UNDER
Application No. 55123 Permit No. 41333
IN THE NAME OF

Surveyed: June 5, 2002 by: J. Miller

RECEIVED

FEB 03 2003

WATER RESOURCES DEPT.
SALEM, OREGON

41023-179-237A JM 01-22-2003