


T.2N., R.40E., W.M.

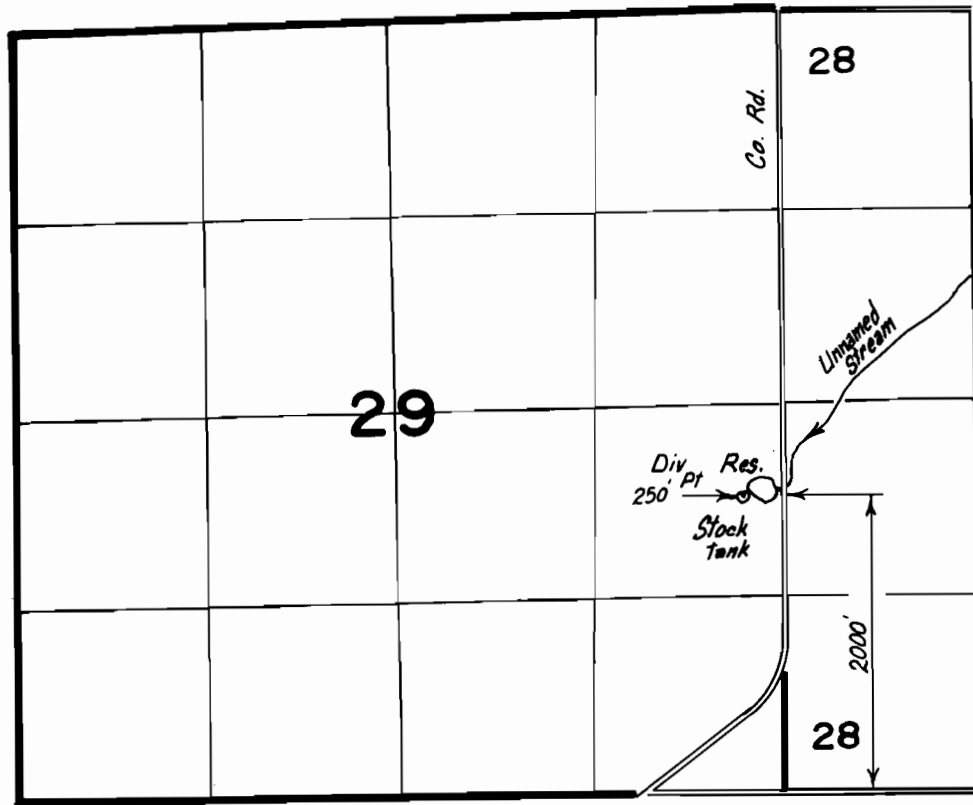

FINAL PROOF SURVEY UNDER


Scale: 1" = 1320'

Application No. **R56361** Permit No. **R6679**
IN NAME OF

DAVID C. LARSON

Surveyed 10-29-1987, by Vern Church

41061-179-311R KK 2/89