


T. 11 S., R. 43 E., W.M.

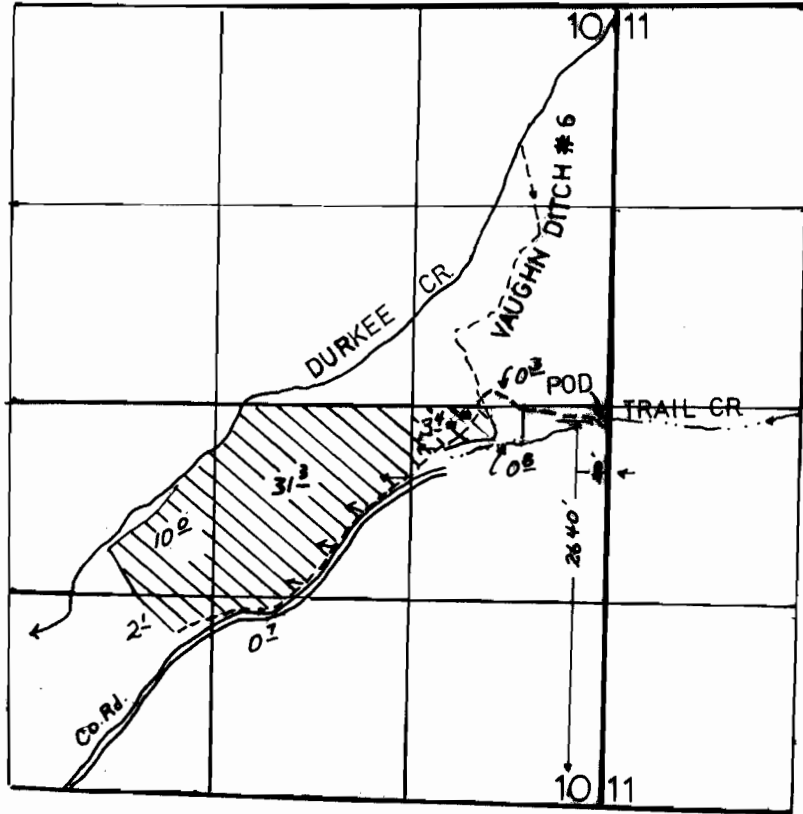

1" = 1320'

FINAL PROOF SURVEY
UNDER

Application No. 57419 Permit No. 43330
IN NAME OF

JOHN AND KAREN PATTERSON

Surveyed JULY 28, 1994, by L. MILLER