


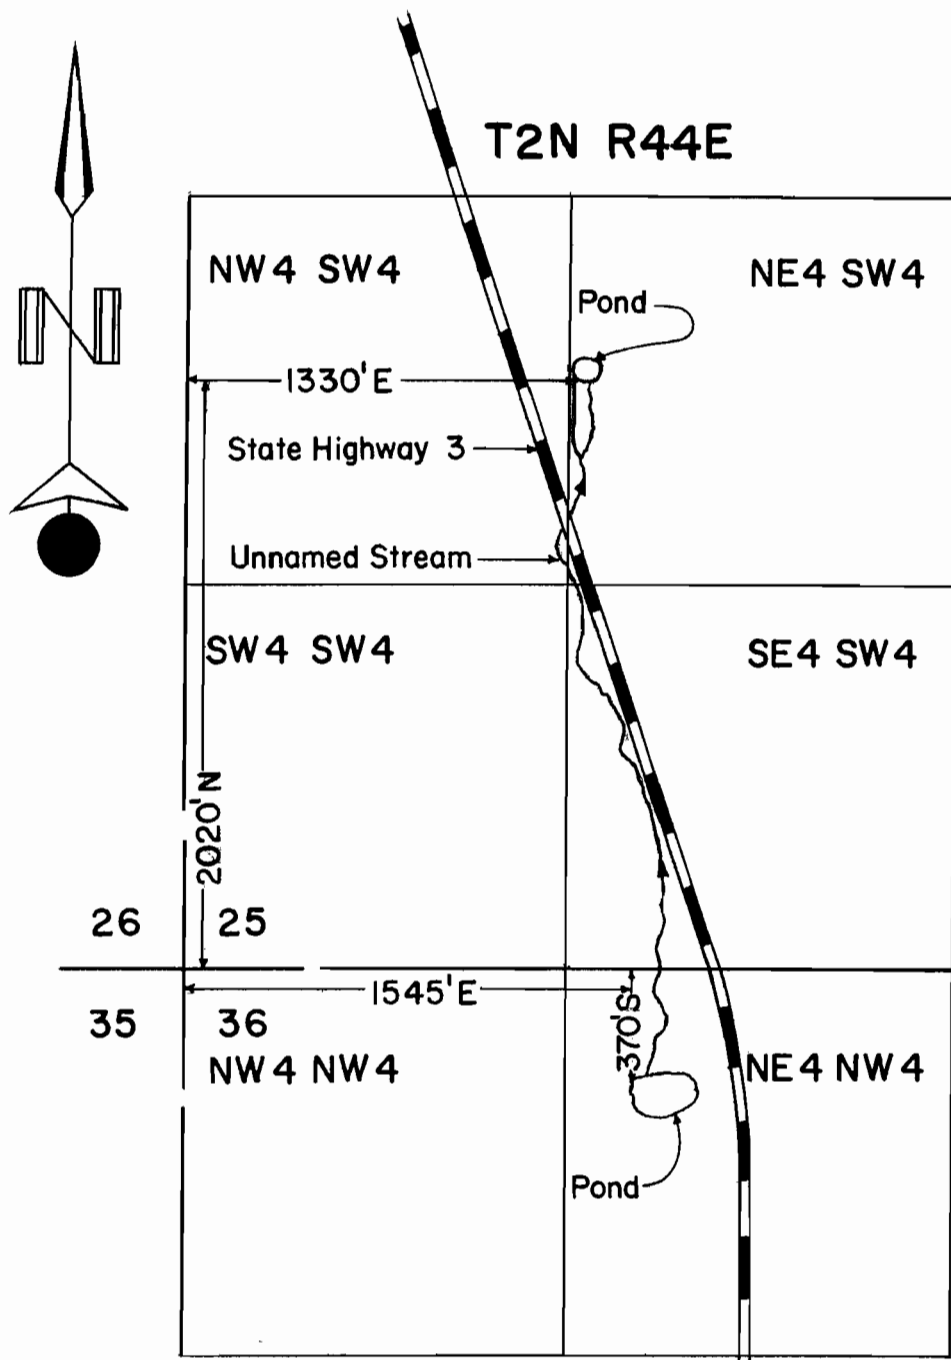

Application No. *R-56204*
 Permit No. *R 6671*

BOISE CASCADE CORPORATION

WATER RIGHTS MAP

Scale 1" = 660'

3/77

RECEIVED

JUL 14 1977

WATER RESOURCES DEPT
 SALEM, OREGON