


Application No. 66110
Permit No. 48057

T.8S.,R.11W.,W.M.

RECEIVED
SEP 19 1983
WATER RESOURCES DEPT.
SALEM, OREGON

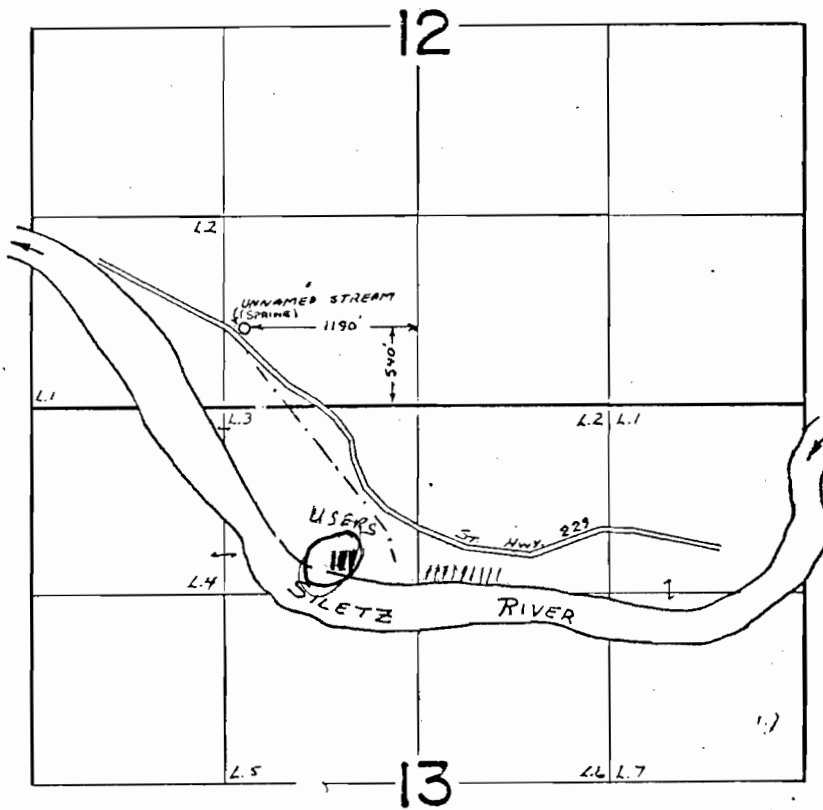

~~FINAL PROOF SURVEY~~
UNDER

Application No. Permit No.
IN NAME OF

Fun. River Improvement Dist.

Surveyed 19. by