


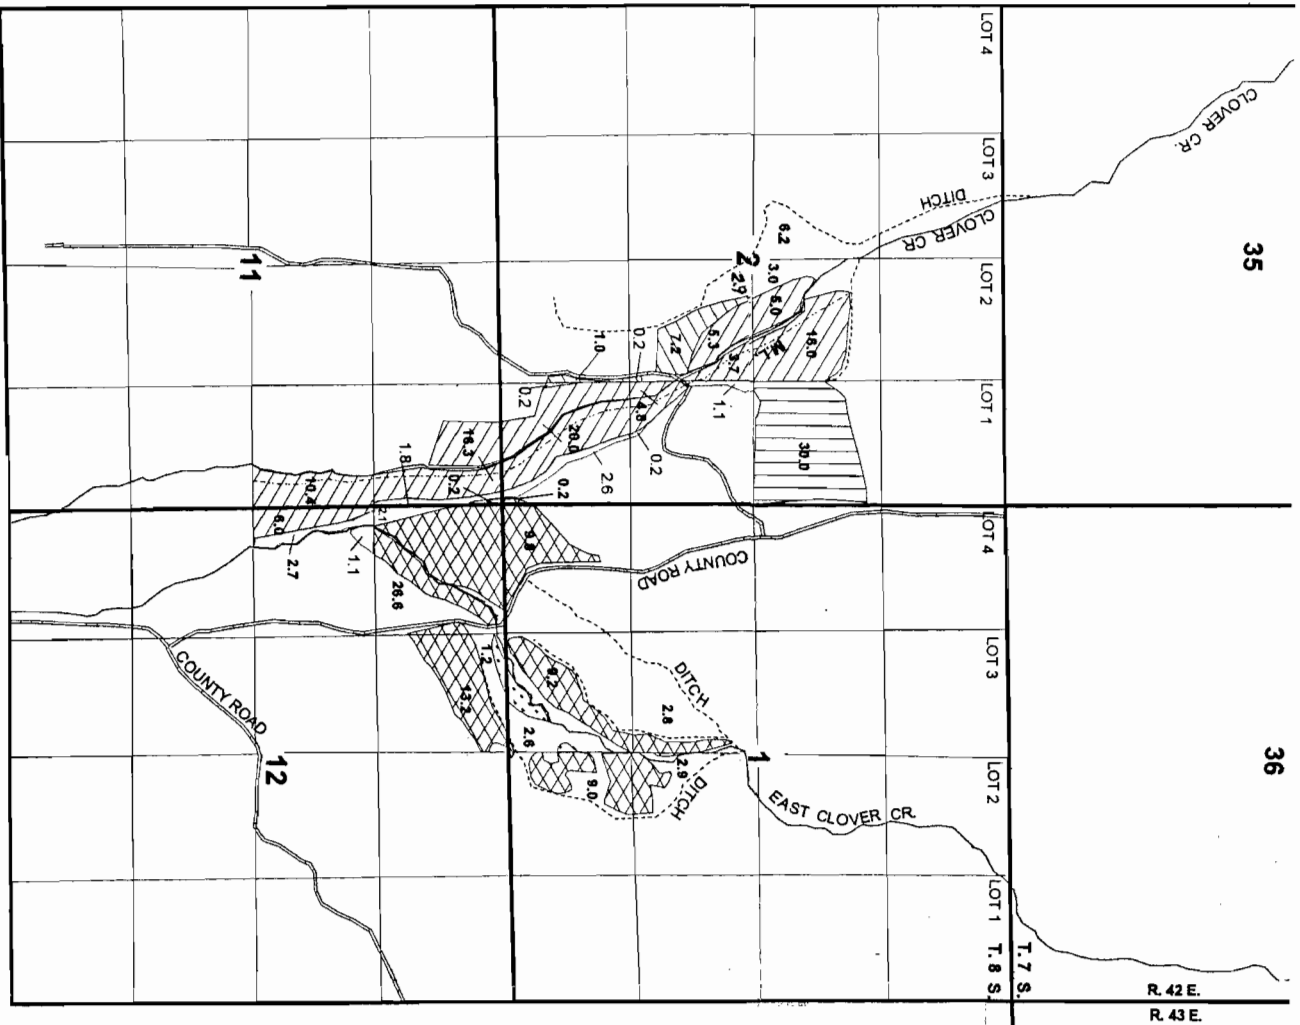

FINAL PROOF SURVEY

UNDER

Application No. 69038

Permit No. 60428

IN THE NAMES OF
ROY ALLAN HUNT
AND
MORRIS G. COOK

Surveyed: September 13, 2002 by: J. Miller

RECEIVED
OCT 03 2002
WATER RESOURCES DEPT.
SALEM, OREGON



Supplemental to C # 4344
Supplemental to C # 3939
Supplemental to C # 2277C
Supplemental to C # 2287I
Supplemental to C # 10032