
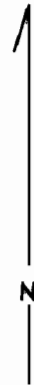


T.2N. R.40E., W.M

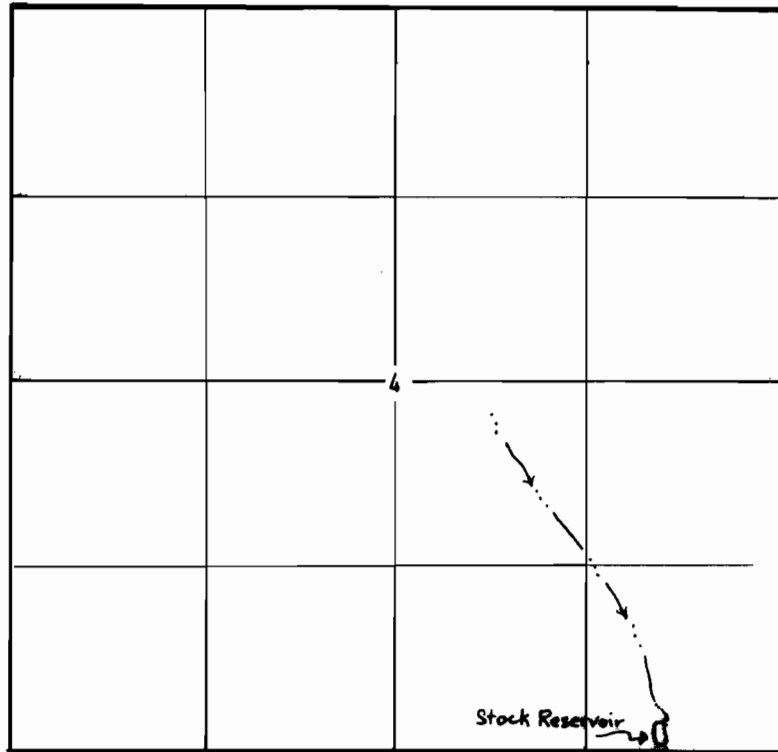

1" = 1320'

**FINAL PROOF SURVEY
UNDER**

**Application No. R-56554 Permit No. R-9070.....
IN NAME OF**

JOSEPH MICHAEL & KATHLEEN ANN BECKHAM

Surveyed 3-20..... 1991., by K.KEMP.....