


# T. 2 N., R. 33 E., W.M.

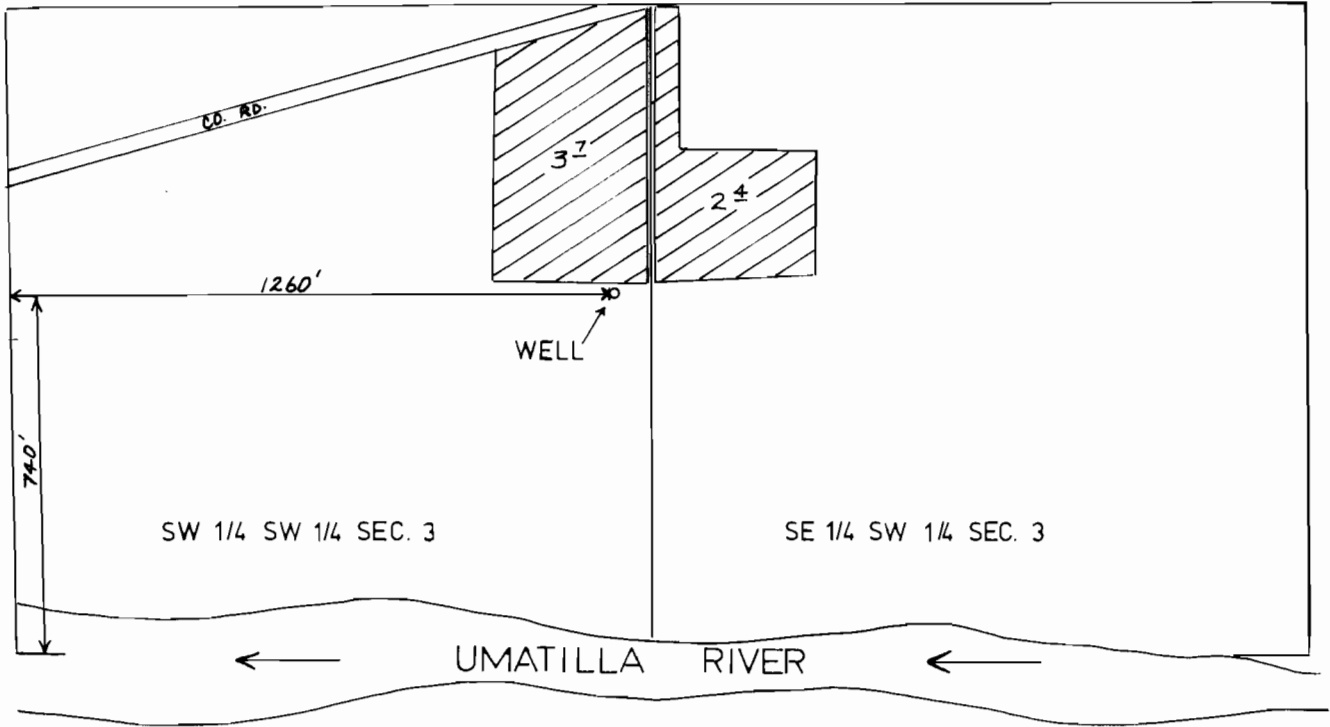

## FINAL PROOF SURVEY

UNDER

Application No. G-11487 Permit No. G10598  
IN NAME OF

A. J. AND SUSAN FREY

Surveyed 1-24, 1991, by K. KEMP

1" = 400'