


T. 3 S., R. 48 E., W.M.

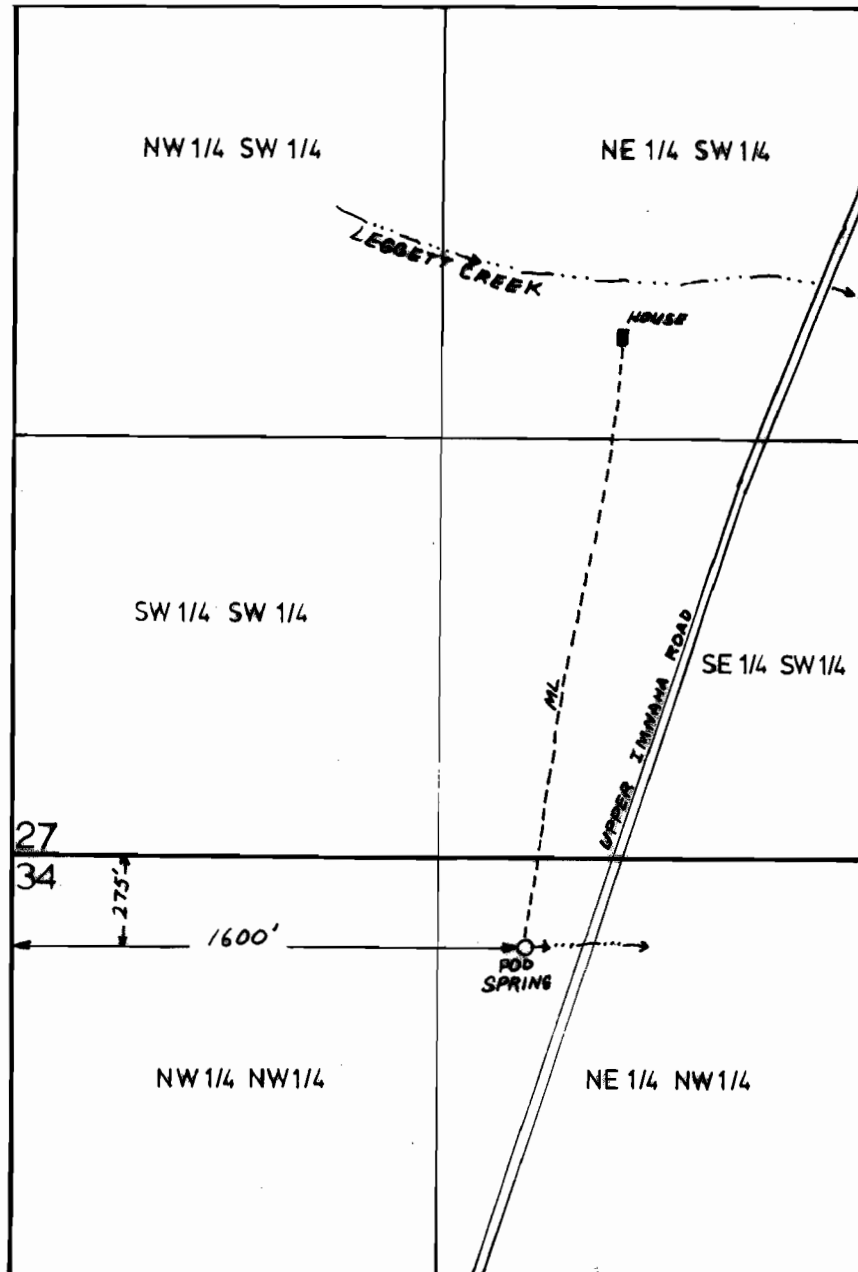

FINAL PROOF SURVEY

UNDER

Application No. 61645 Permit No. 45752
IN NAME OF

GARY A. JONES

Surveyed 6-30, 1992, by J. MILLER