


T.1N. R.48E., W.M.

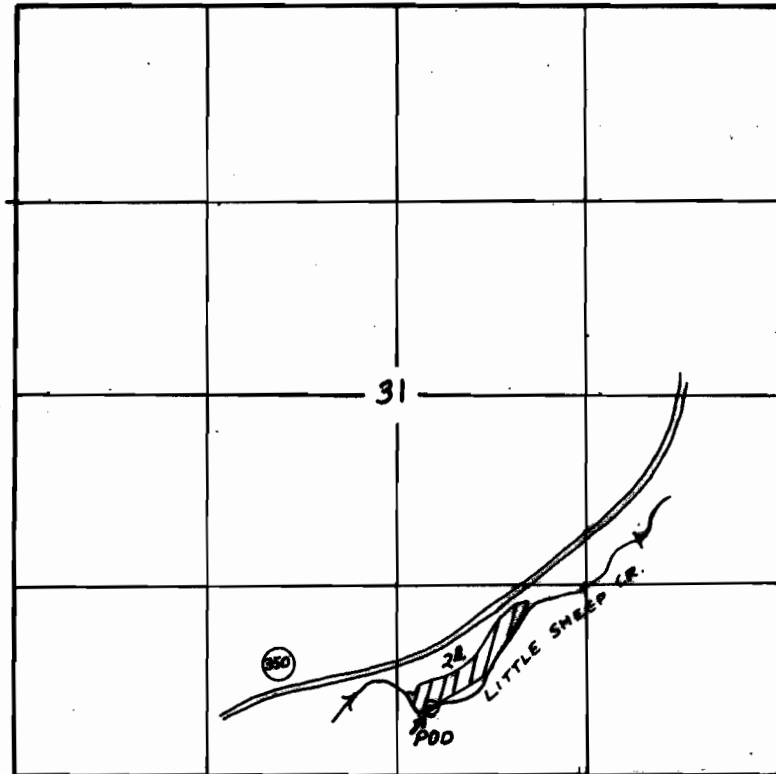

1" = 1320'

POD - 460' N. and 220' E. FROM S 1/4
CORNER SECTION 31

FINAL PROOF SURVEY UNDER

Application No. 58171... Permit No. 43833.....
IN NAME OF

.....BERNARD J. HENRY.....

Surveyed 10-8..... 1990., by K. KEMP.....