


T. 4 S., R. 40 E., W.M.

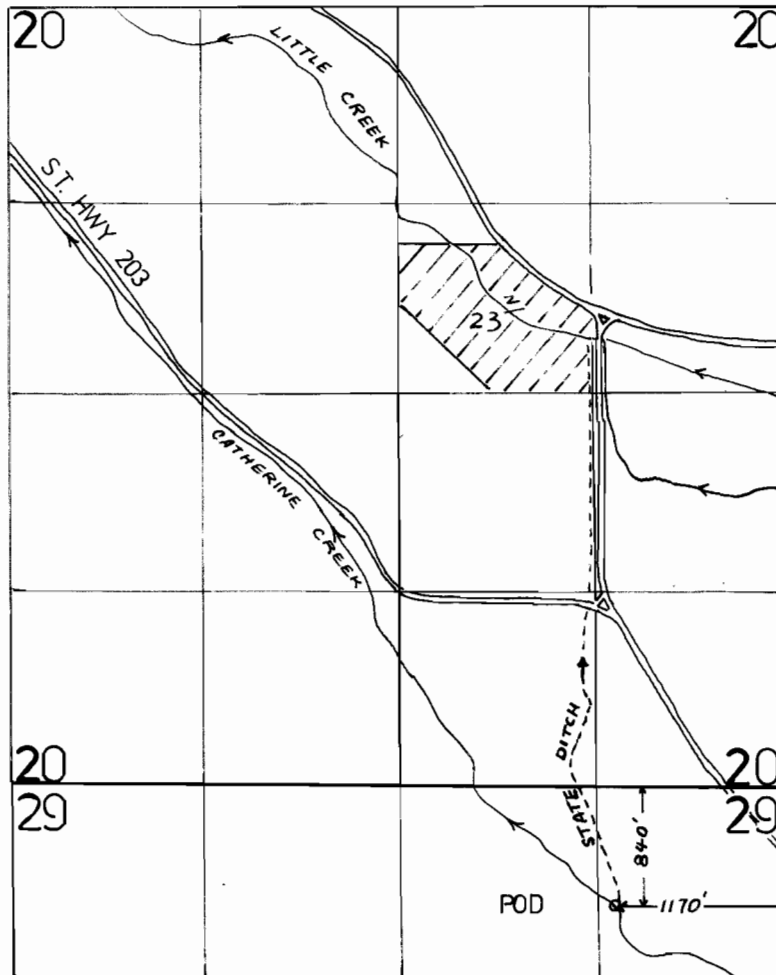

1" = 1320'

FINAL PROOF SURVEY

UNDER

Application No. 57581 Permit No. 43399

IN NAME OF

DON E. ROBINSON

Surveyed 7-9, 1984, by V. L. CHURCH