


T. 8 S., R. 46 E., W.M.

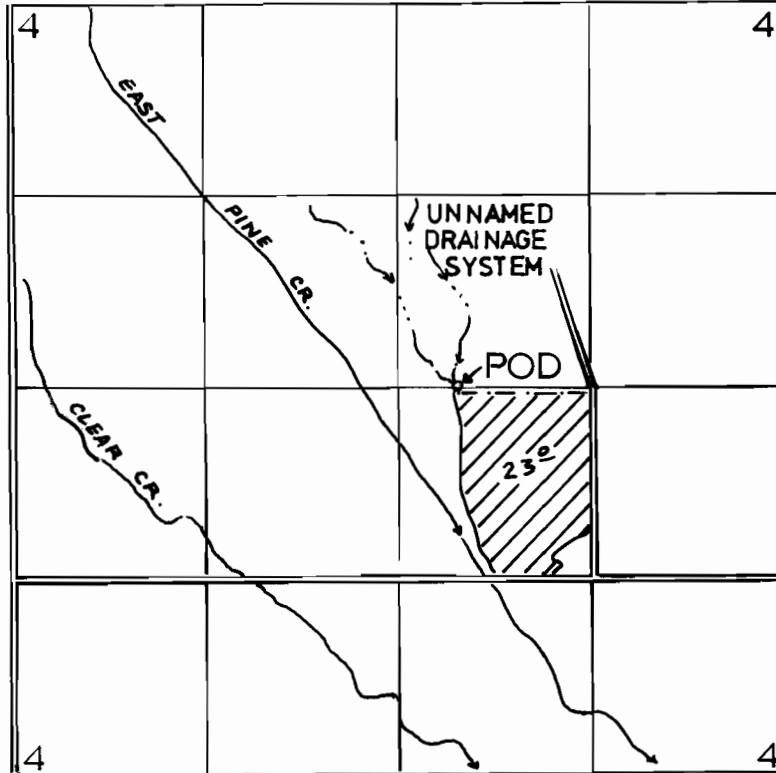

POD - 10' N. & 400' E. FROM THE CENTER OF SEC. 4.

RECEIVED

FEB - 2 1998

WATER RESOURCES DEPT
SALEM, OREGON

FINAL PROOF SURVEY

UNDER

Application No. 56277 Permit No. 42794
IN NAME OF

BETH L. ROWEN & ESTATE OF HAROLD ROWEN

Surveyed 10-22, 1991, by J. MILLER

BBB-2KK-142 JM