


RECEIVED

AUG 11 1997

**T. 14 S., R. 31 E., W.M.**

WATER RESOURCES DEPT  
SALEM, OREGON

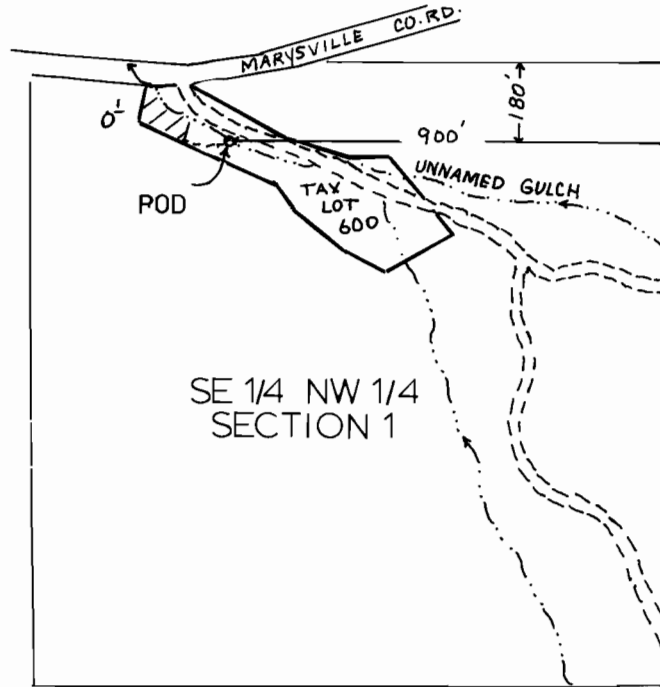

**FINAL PROOF SURVEY**

UNDER

Application No. 58002 Permit No. 43651

IN NAME OF

WILLIAM FIELDS

Surveyed OCTOBER 28, 1992, by J. MILLER