


T. 12 S., R. 41 E., W.M.

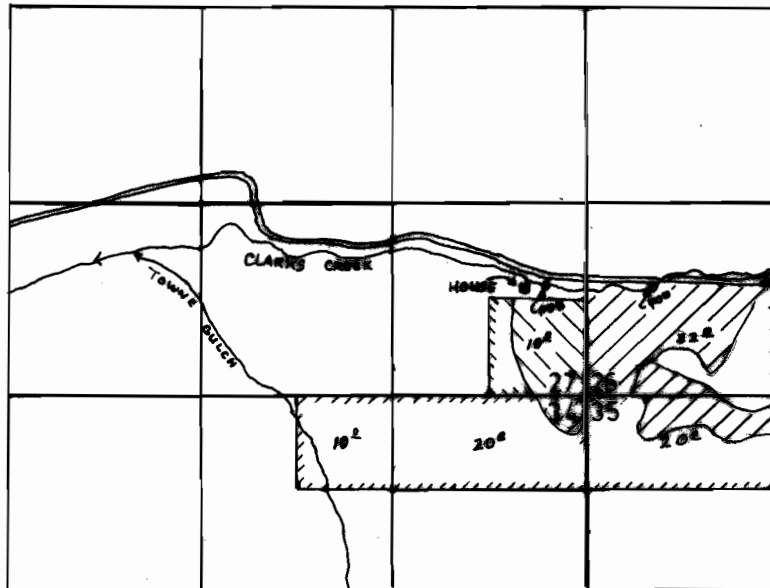

POD 750' N. AND 550' E. FROM SW COR. SEC. 26.

POD 750' N. AND 270' W. FROM SE COR. SEC. 27



1" = 1320'

P# 46510
BOUNDARY

  APPROXIMATE
AREA MINED

P# 46634
BOUNDARY

  APPROXIMATE
AREA MINED

FINAL PROOF SURVEY

UNDER

Application No. 62999 62352 Permit No. 46634 46510
IN NAME OF

JOHN K. AND WINIFRED E. KYGAR

Surveyed 6-26, 1992, by J. MILLER