



T.1S., R.45E., W.M.

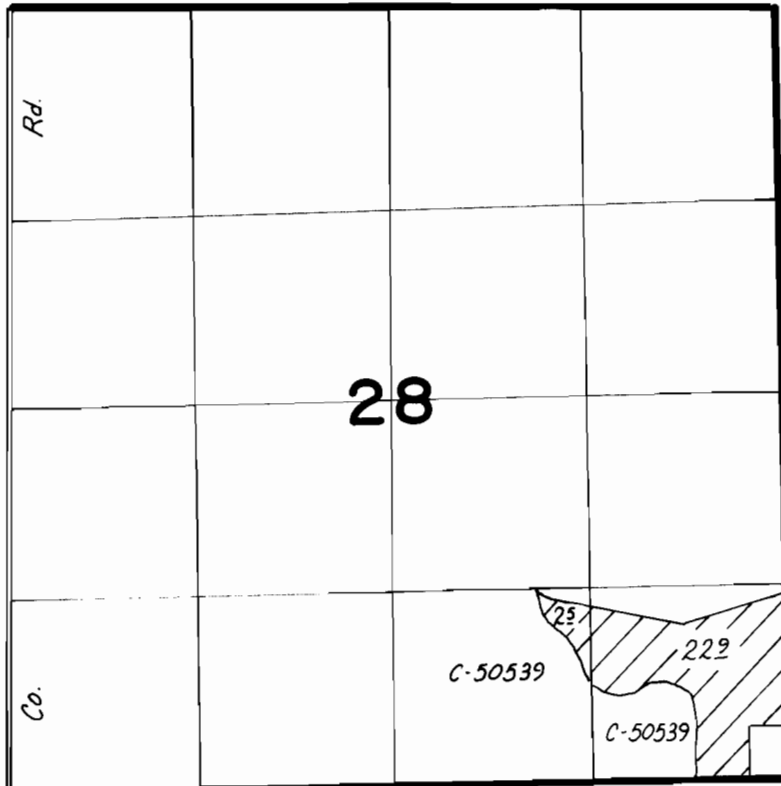

T.3S., R.45E., W.M.

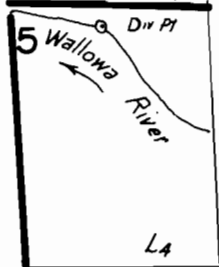

Div. pt. loc. 624' S.77° 20' E.
from NW cor. sec. 5.



Scale: 1" = 1320'

FINAL PROOF SURVEY UNDER

Application No. ~~63246~~ Permit No. ~~46931~~.....
IN NAME OF

ROY W. & WILFRED R. DAGGETT

Surveyed ..8-18..... 19.88., by ..Vern...Church.....