


T. 2 N., R. 48 E., W.M.

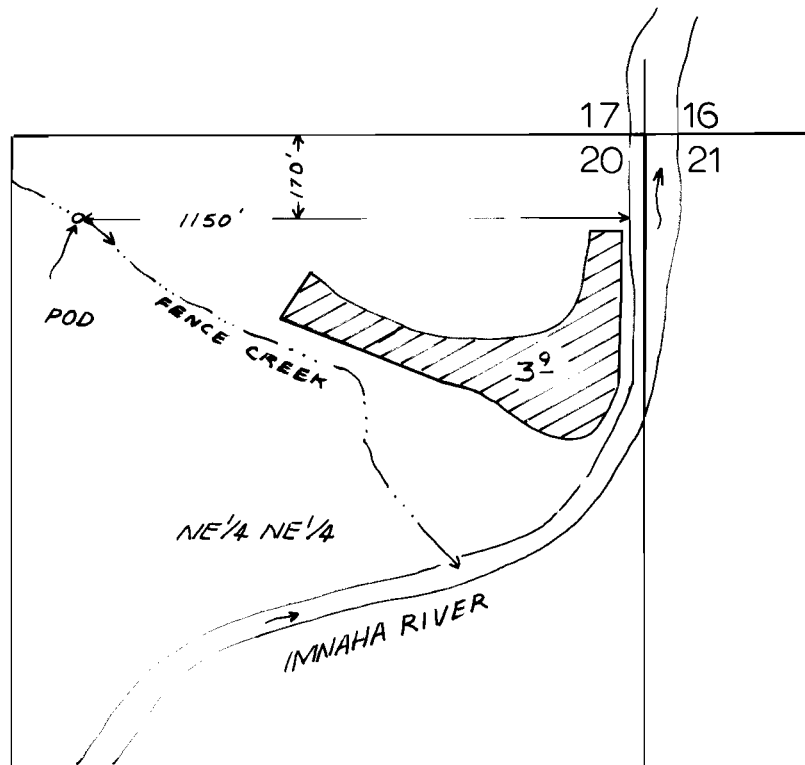

FINAL PROOF SURVEY

UNDER

Application No. 63734 Permit No. 47082

IN NAME OF

EUGENE MARR

Surveyed 10-10, 1990, by K. KEMP