


T. 2 S., R. 39 E., W.M.

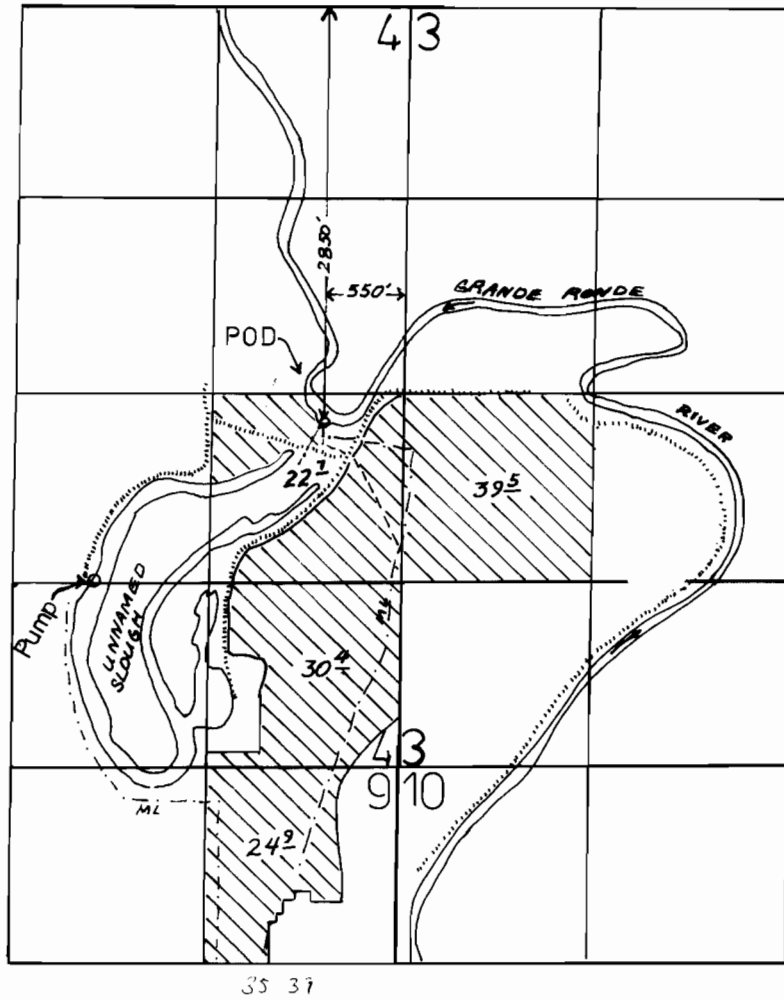

FINAL PROOF SURVEY

UNDER

Application No. 68541 Permit No. 49493

IN NAME OF

OREGON DEPARTMENT OF VETERANS AFFAIRS

Surveyed 7-7, 1993, by J. MILLER