
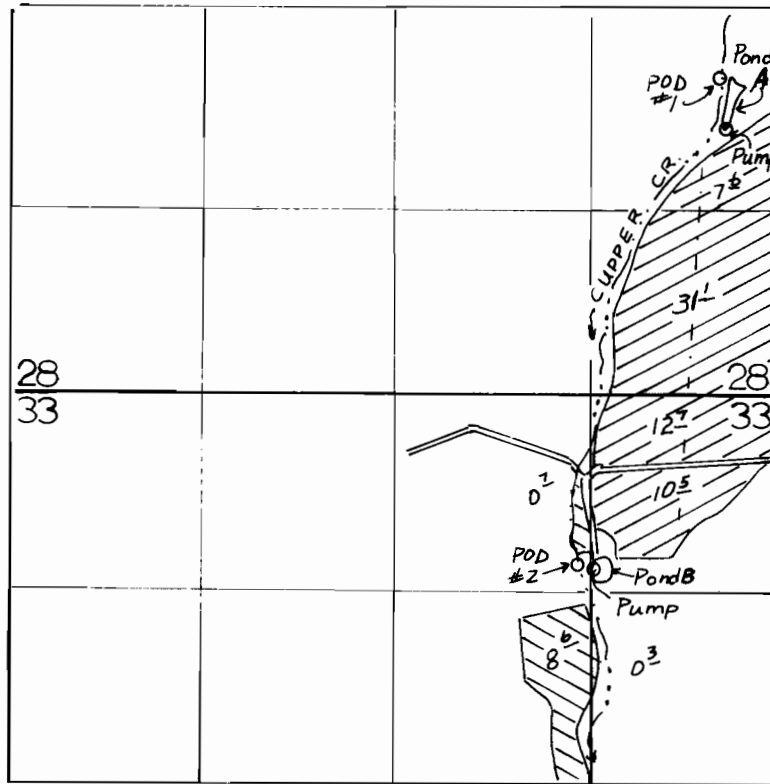
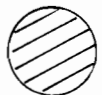


Township 8 S., Range 27 E., W.M.

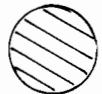

-  POD 1
RES. A
-  POD 2
RES. B

POD 1 - 500' S. & 450' W. FROM E 1/4 COR. SEC. 28.
 POD RES. A - 830' S. & 400' W. FROM E 1/4 COR. SEC. 28.
 POD 2 - 1175' S. & 1400' W. FROM NE 1/4 COR. SEC. 33.
 POD RES. B - 1200' S. & 1280' W. FROM NE 1/4 COR. SEC. 33.

1" = 1320'

FINAL PROOF SURVEY UNDER

R-57119 R 7345
 Application No. 57120 Permit No. 43090
 IN NAME OF

JERRY RUSSEL & KATHRYN KLOSKE

Surveyed OCT. 29 1998, by J. Miller