
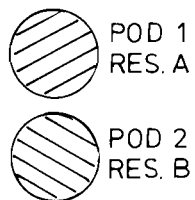


Township 8 S., Range 27 E., W.M.

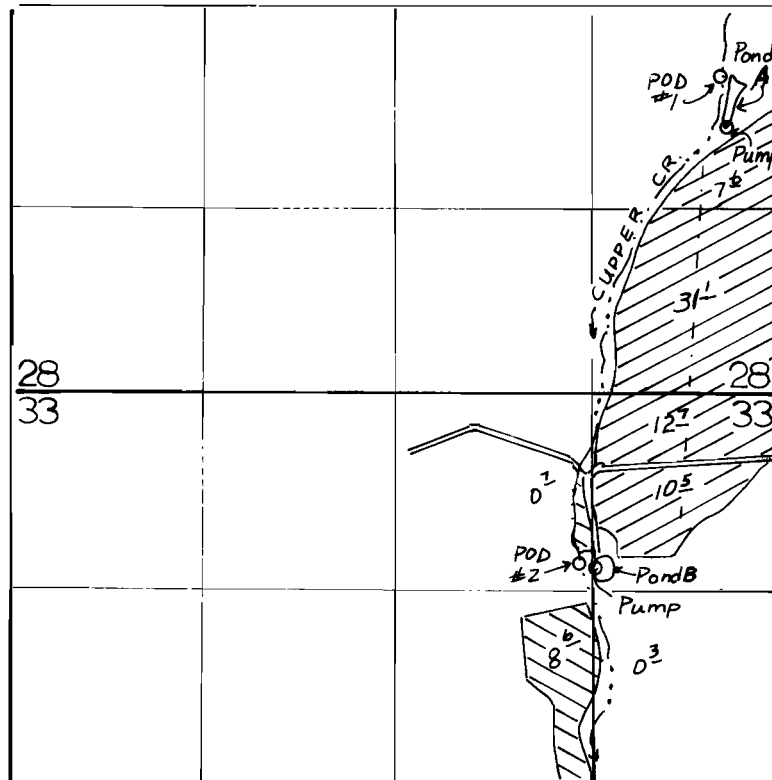

POD 1-500'S. & 450'W. FROM E 1/4 COR. SEC. 28.
POD RES. A-830'S. & 400'W. FROM E 1/4 COR. SEC. 28.
POD 2-1175'S. & 1400'W. FROM NE 1/4 COR. SEC. 33.
POD RES. B-1200'S. & 1280'W. FROM NE 1/4 COR. SEC. 33.

1"= 1320'

FINAL PROOF SURVEY UNDER

R-57119 R 7345
Application No. 57120 Permit No. 43090
IN NAME OF

JERRY RUSSEL & KATHRYN KLOSKE

Surveyed OCT. 29 1998, by J. Miller