


Township 8 S., Range 27 E., W.M.

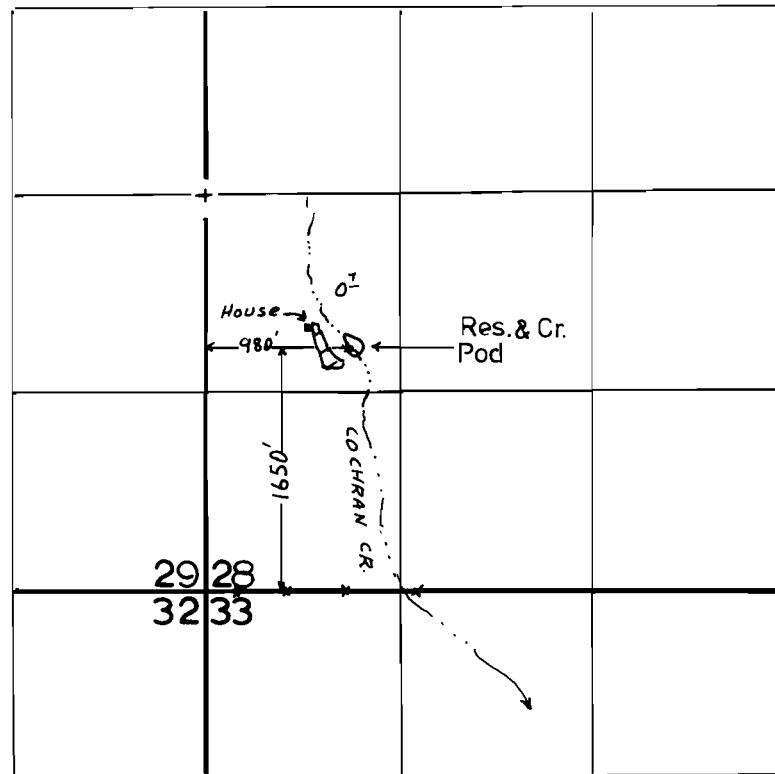

1"= 1320'

**FINAL PROOF SURVEY
UNDER**

R 57021 R 7732
Application No. 56659... Permit No. 43613.....
IN NAME OF

GERALD RUSSELL

Surveyed OCT. 29. 19. 98, by J. Miller