


T. 2 S., R. 44 E., W.M.

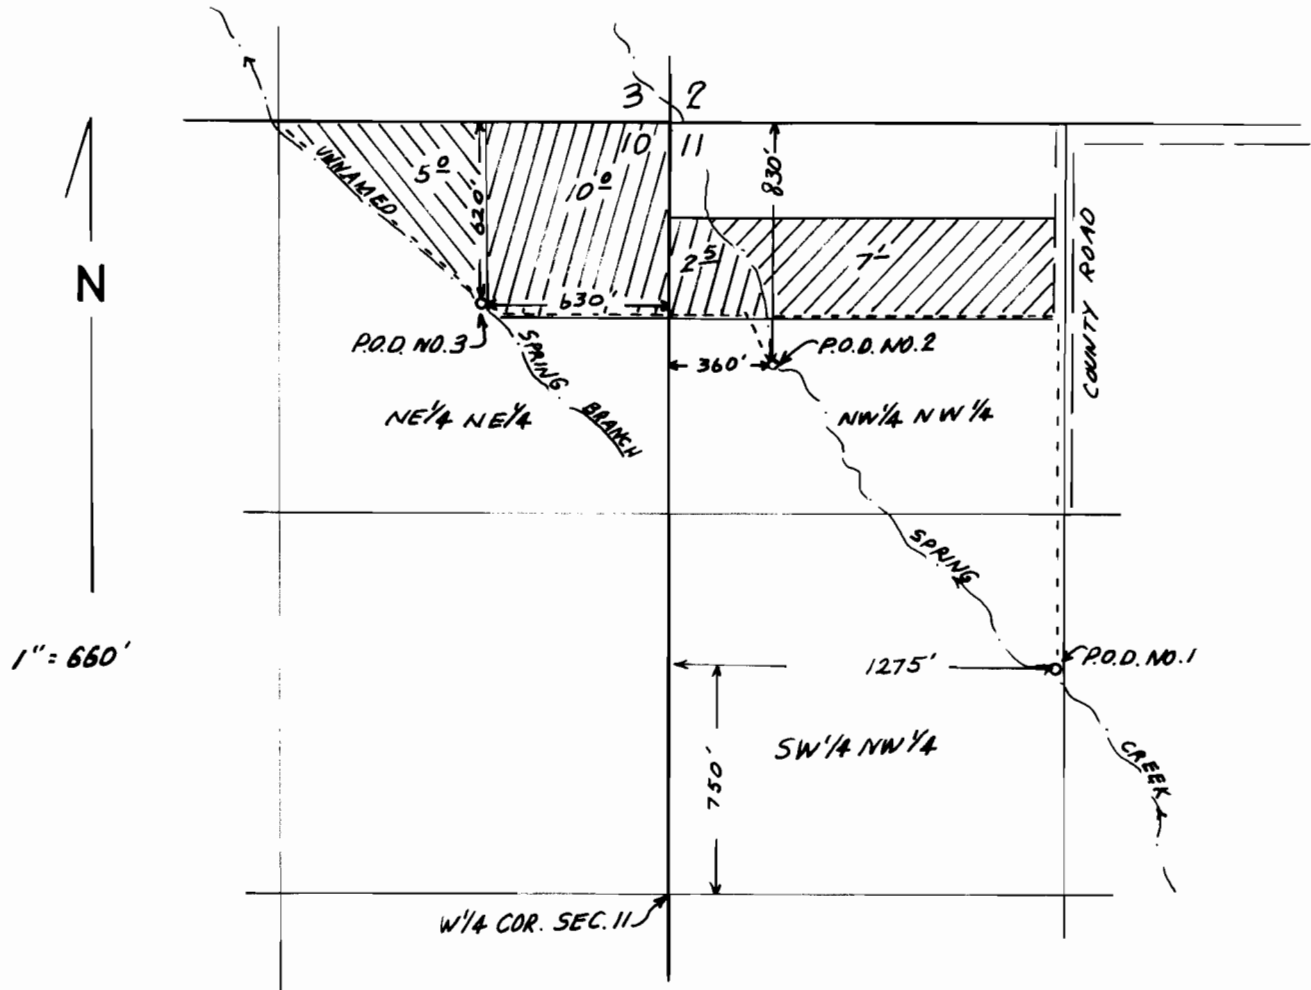

FINAL PROOF SURVEY

UNDER

Application No. 62979 Permit No. 47271
IN NAME OF

DERRELL G. WITTY

Surveyed 6-24, 1994, by J. MILLER