


T. 1 S., R. 38 E., W.M.

SW 1/4 SE 1/4 SEC. 9

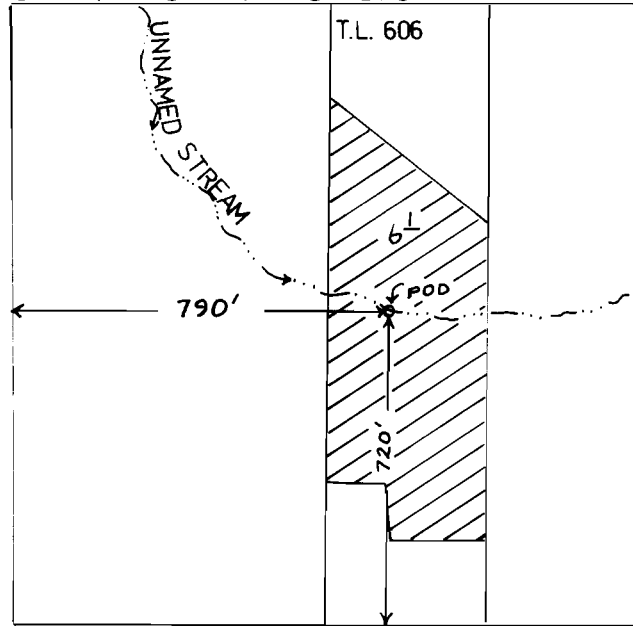

1" = 400'

FINAL PROOF SURVEY

UNDER

Application No. 59177 Permit No. 44819

IN NAME OF

DAVID AND KARLYNE LANDRUM

Surveyed 3-20, 1991, by K. KEMP