


T. 13 S., R. 43 E., W.M.

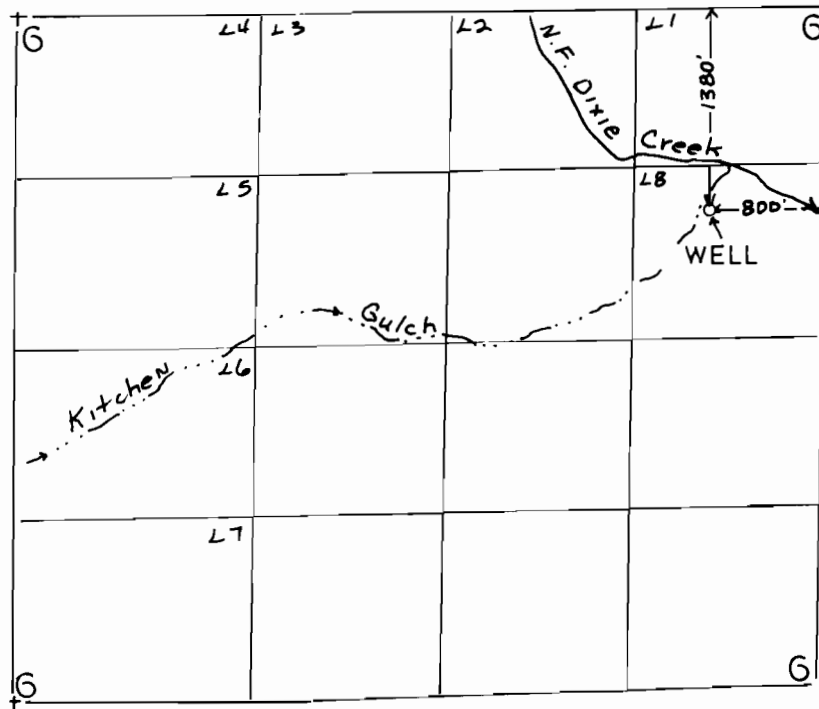

1" = 1320'

FINAL PROOF SURVEY

UNDER

Application No. G-10196 Permit No. G-9594
IN NAME OF

BROKEN PICK MINING, INC.

Surveyed AUG 27, 1994 by J. MILLER