


T. 13 S., R. 43 E., W.M.

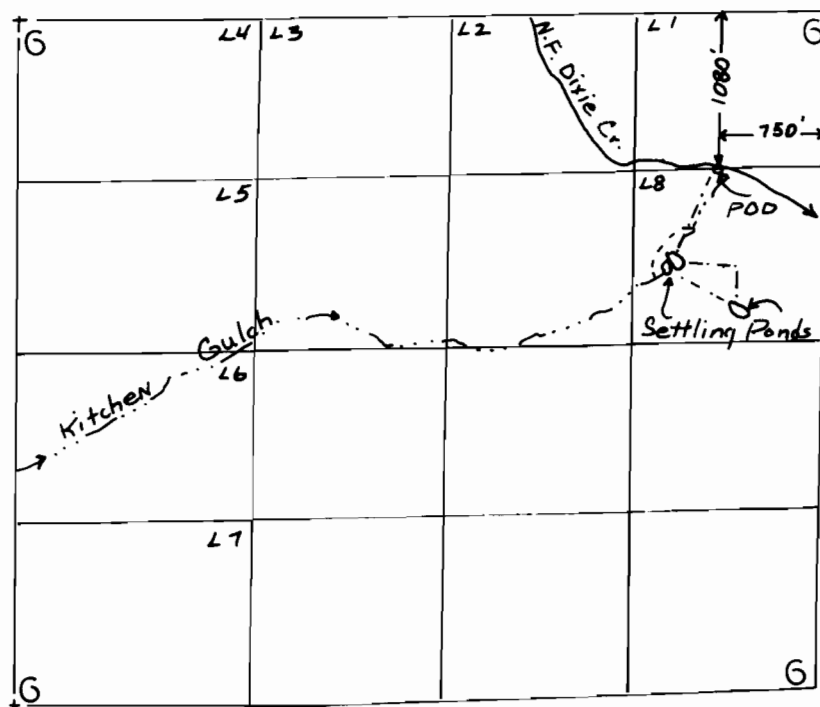

1" = 1320'

FINAL PROOF SURVEY

UNDER

Application No. 61323 Permit No. 46475
IN NAME OF

MICHAEL T. DOLAN

Surveyed JULY 27, 1994, by J. MILLER