


TOWNSHIP 2 SOUTH, RANGE 45 EAST, W.M.

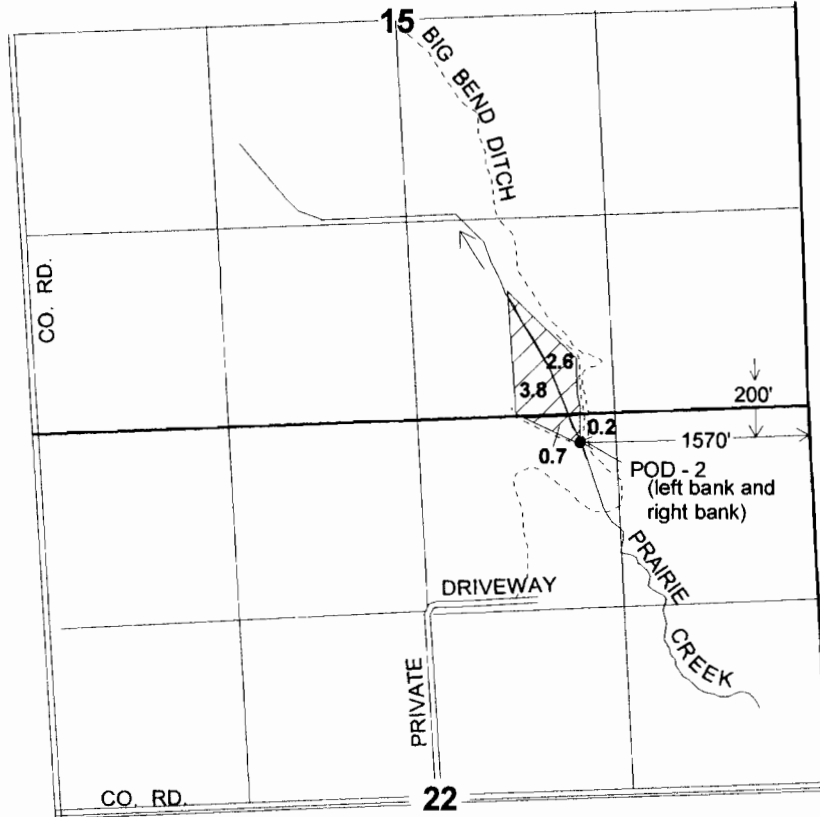

FINAL PROOF SURVEY

UNDER

Application No. 57350 Permit No. 43148

IN THE NAME OF

TOM R. BUTTERFIELD

Surveyed: June 19, 2002 by: J. Miller

RECEIVED

FEB 03 2003

WATER RESOURCES DEPT.
SALEM, OREGON