


T.5N. R.45E.,W.M.

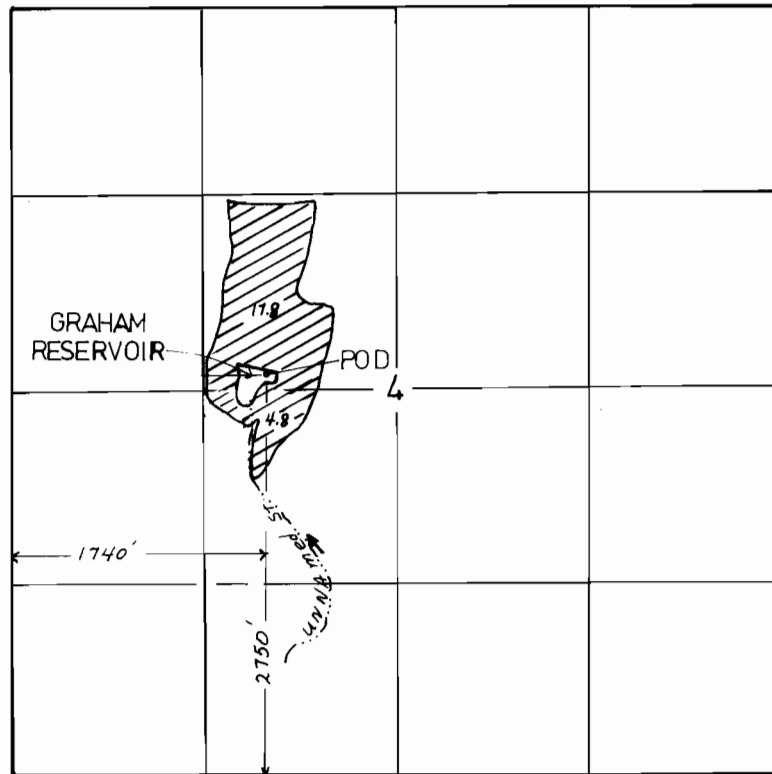

1" = 1320'

**FINAL PROOF SURVEY  
UNDER**

Application No. R-54034 53984 Permit No. R-6453 40470  
**IN NAME OF**

.....LEE GRAHAM.....

Surveyed 10-7 1990, by K. KEMP.....